IREDELL COUNTY HEALTH DEPARTMENT

STATESVILLE 704-878-5305 MOORESVILLE 704-664-5281

IMPROVEMENT PERMIT / AUTHORIZATION TO CONSTRUCT / OPERATION PERMIT / EXISTING SYSTEM INSPECTION

PERMIT# 122432 PIN# 4636 67 3763 DATE 2/25/05

OWNER OR CONTRACTOR Viorel Tudur PHONE: Business 602-291-4885 Home

ADDRESS 340 Bradford Dr. apt. 22

LOCATION 1100, T1 Wellandlin TR - TR Dabbling Duck, Iotan(R) - corner lot

SUBDIVISION Hunters Blind BLOCK / SECTION LOT 19 LOT AREA .44Ac SITE CLASS PS DESIGN FLOW 480 L.T.A.R. .3

Septic Tank: 1000 Gallons; STB 925 Date 5/25/05

Pump Tank: 1000 Gallons; PT 302 Date 6/20/05

Pump Make: Model Serial No.

Nitrification Field: No Fields 1 Square Feet 540/810 Linear Feet 270

No Lines 3 @ 90' Trench Width 2' Max Trench Bottom Depth 3' Gravel Depth NA

[X] New System [ ] Repair System Type: I, II, III, IV, V, VI

System Description: Pro Bond - 16" PIPS

Repair System Description: SAME SYSTEM

Maintenance Agreement Required: [X] Yes [ ] No

[X] House/Mod. Home No. Bedrooms 4

[ ] Mobile Home No. Bathrooms 3

[ ] Business No. Employees

[ ] Other

[ ] Slab [X] Crawl Space [ ] Basement w/plumbing [ ] Basement wo/plumbing


Water Supply: [X] Individual [ ] Public [X] Community

Comments:/Conditions: Very tight no changes without Refill approval. 3/16" holes - 2.5' pressure head in each line. Absolutely no grading in drainfield or Repair Area.

Comments:/Conditions: This house hooked to Town Water after two Dry Holes" at the rear of this property.

1" = 40'

INITIAL SITE SKETCH

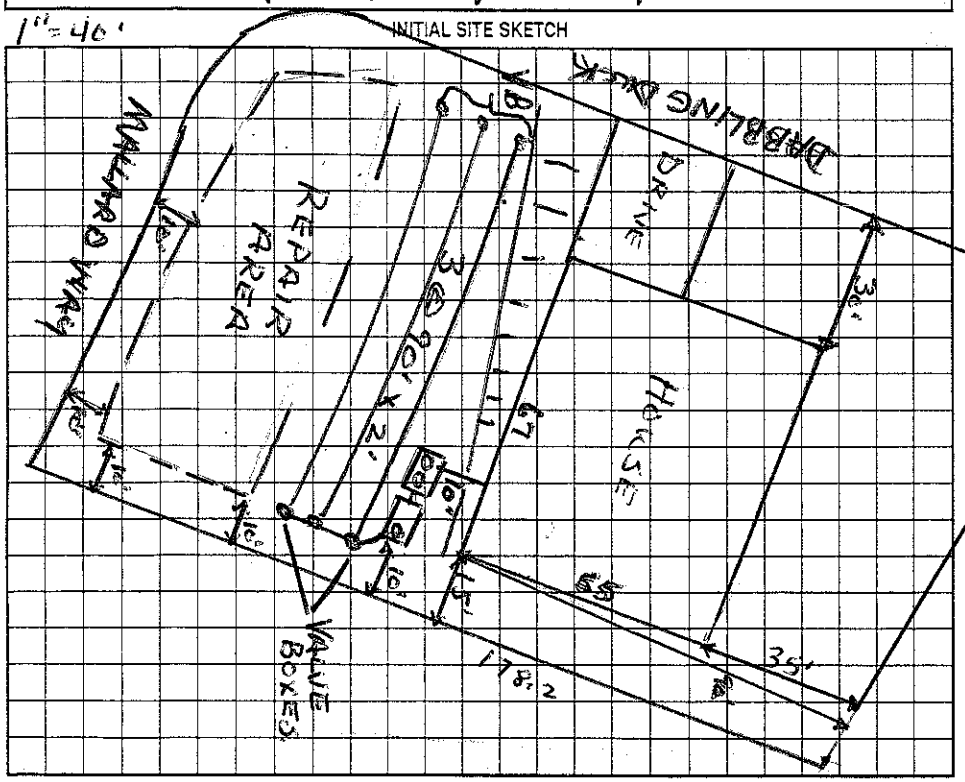

AS BUILT SKETCH

Permit can be suspended or revoked if any false information is supplied toward securing the permit/any unauthorized changes are made to the site/any unauthorized changes are made in the installation of the system. Improvement Permit with plat valid without expiration. Improvement Permit with site plan valid for sixty months. Authorization to Construct is valid for ~~a period~~ equal to that of Improvement Permit – not to exceed sixty months.

Signed: * VIORA TUDUR date 7-28-05 Installed by: Rowan Septic Tank

Improvement Permit by: Wesley Sparks R.S. date 2/25/05 Operation Permit by: Wesley Sparks R.S. date 1/25/06

Authorization to Construct by: Wesley Sparks R.S. date 2/25/05 Existing System Inspection by: date

HEALTH DEPT. COPY: WHITE OWNER COPY (FINAL): YELLOW OWNER COPY (INITIAL): PINK