2.00 ✓

IREDELL COUNTY HEALTH DEPARTMENT

STATESVILLE 704-878-5305 MOORESVILLE 704-664-5281

IMPROVEMENT PERMIT / AUTHORIZATION TO CONSTRUCT / OPERATION PERMIT / EXISTING SYSTEM INSPECTION

PERMIT# 140417 204950 PIN# 4636701126 DATE 4-2-07

OWNER OR APPLICANT Tony M. Brown/CCSI PHONE: Business 704-533-0651 Home 704-786-8878

ADDRESS 3450 Zion Church Rd Concord NC 28025

LOCATION Brawley School Rd Tl Stutts Tl Commodore Lp TR Osprey on right

SUBDIVISION Comm. Penninsula BLOCK / SECTION ____ LOT 223 LOT AREA .25 Ac SITE CLASS. PS DESIGN FLOW 360gpd L.T.A.R. .3 gpd /ft²

Septic Tank: 1000 Gallons: STB 825 Date 8/20/14
Pump Tank: ____ Gallons: PT ____ Date ____
Pump Make: ____ Model ____ Serial No. ____
Nitrification Field: No Fields 1 Square Feet 1200 Linear Feet 300
No Lines 4@75' Trench Width 36" Max Trench Bottom Depth 36"

☒ New System ☐ Repair ☐ Expansion System Type: I II III IV V VI
System Description: 25% reduction gravity
Repair System Description: 15A NCAC 18A.1945 max. feasible
Maintenance Agreement Required: ☐ Yes ☒ No
Gravel Depth NA ☒ Gravity ☐ Pressure

☒ House/Mod. Home No. Bedrooms 3
☐ Mobile Home No. Persons 6
☐ Business No. Employees ____
☐ Other ____

Water Supply: ☐ Individual ☒ Public ☒ Community


☐ Slab ☒ Crawl Space ☐ Basement w/plumbing ☐ Basement wo/plumbing

Comments:/Conditions: Remove debris from surface
Slight shaping needed at top trench line
D-Box w/ Speed levelers or flow splitter such as Zoeller


Comments:/Conditions: 7/29/14 Reviewed Floor plans in Compliance With Improvement Permit

1" = 40'

INITIAL SITE SKETCH

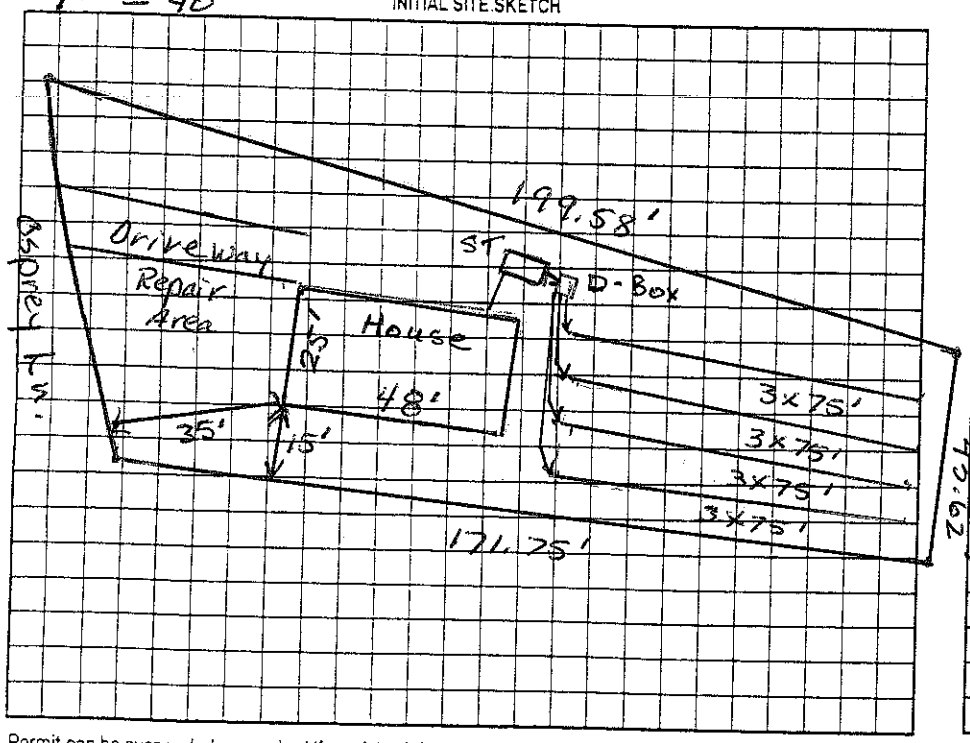

AS BUILT SKETCH

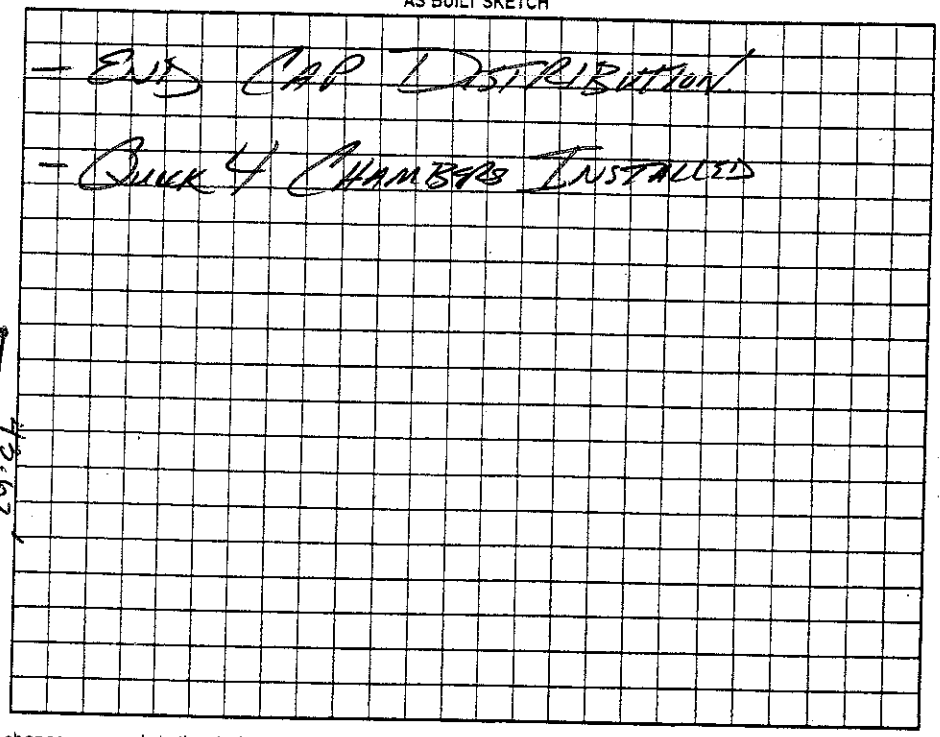

Permit can be suspended or revoked if any false information is supplied toward securing the permit/any unauthorized changes are made to the site/any unauthorized changes are made in the installation of the system. Improvement Permit with plat valid without expiration ☐ Improvement Permit with site plan valid for sixty months ☒ Authorization to Construct is valid for a period equal to that of Improvement Permit – not to exceed sixty months.

Signed: Elizabeth Brown date 4-24-07 Installed by: Bowman Septic

Improvement Permit by: Judy Melville date 4-2-07 Operation Permit by: _____ date APPROVED OCT 07 2014

Authorization to Construct by: Melissa Dotson RS date 7/29/14 Existing System Inspection by: _____ date _____

HEALTH DEPT. COPY: WHITE OWNER COPY (FINAL): YELLOW OWNER COPY (INITIAL): PINK