IREDELL COUNTY HEALTH DEPARTMENT

STATESVILLE 704-878-5305 PIN# 4636-70-1581 MOORESVILLE 704-664-5281

IMPROVEMENT PERMIT / CERTIFICATE OF COMPLETION / OPERATION PERMIT / EXISTING SYSTEM INSPECTION

PROPERTY DESCRIPTION NO. _____ DATE July 1, '93 TAX MAP NO. _____

OWNER OR CONTRACTOR George MOSER PHONE: Business _____ Home _____

ADDRESS _____

LOCATION 1100 TL 1162 TL 1st 1212 (Commodore Loop) on left past Bowfin Circle

SUBDIVISION Commodore Peninsula BLOCK / SECTION _____ LOT 31 LOT AREA _____ SITE CLASS. _____ L.T.A.R. _____

Water Supply: ☐ Individual ☑ Community ☐ Public

Septic Tank: Existing Gallons; STB _____ Date _____

Pump Tank: _____ Gallons; PT _____ Date _____

Nitrification Field: No Fields 2 (1+EX) Square Feet 900 Linear Feet 300

No Lines 5 in bed Trench Width 15' Trench Depth _____ Gravel Depth 12"

☐ New System ☑ Repair System Type: I, II, III, IV, V, VI

System Description: _____

Repair System Description: gravity bed

Maintenance Agreement Required: ☐ Yes ☑ No

☑ House/Mod. Home No. Bedrooms 3 Garbage Disposal: ☐ Yes ☐ No

☐ Mobile Home No. Bathrooms 1-2 Auto. Dishwasher: ☐ Yes ☐ No


☐ Business No. Employees _____ Auto. Washing Machine: ☐ Yes ☐ No

☐ Other _____ Other _____


☐ Slab ☑ Crawl Space ☐ Basement w/plumbing ☐ Basement wo/plumbing

Comments Use minimum fall from BR valve to NEW repair drainfield.

INITIAL SITE SKETCH LAKE NORMAN

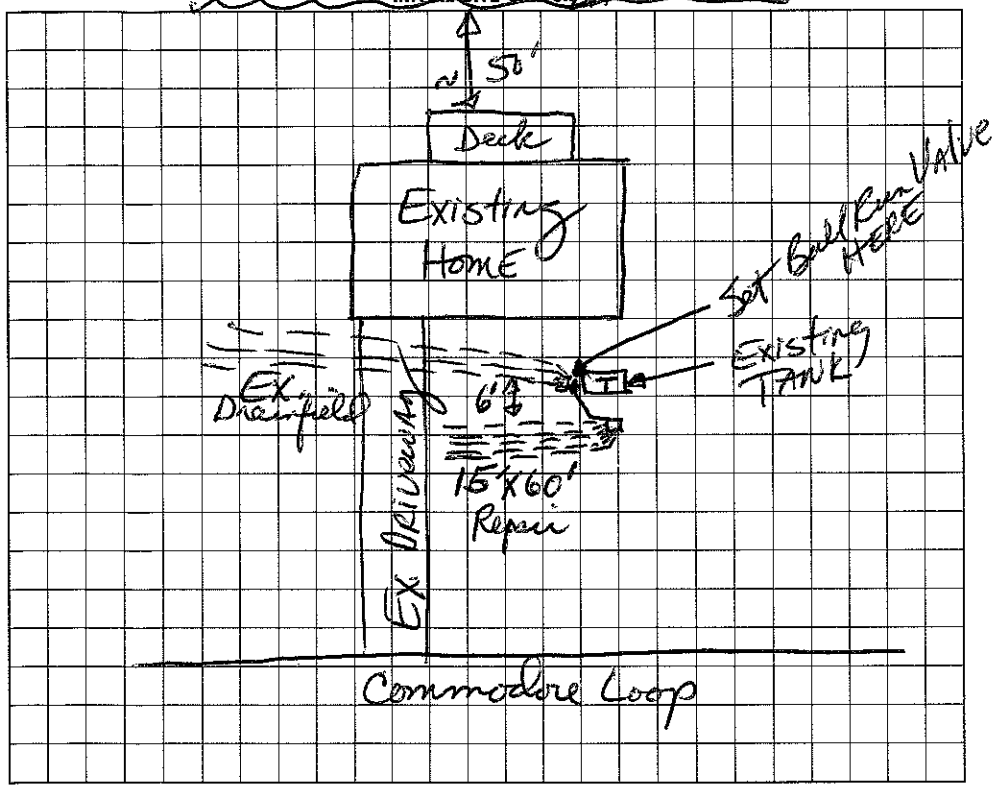

AS BUILT SKETCH

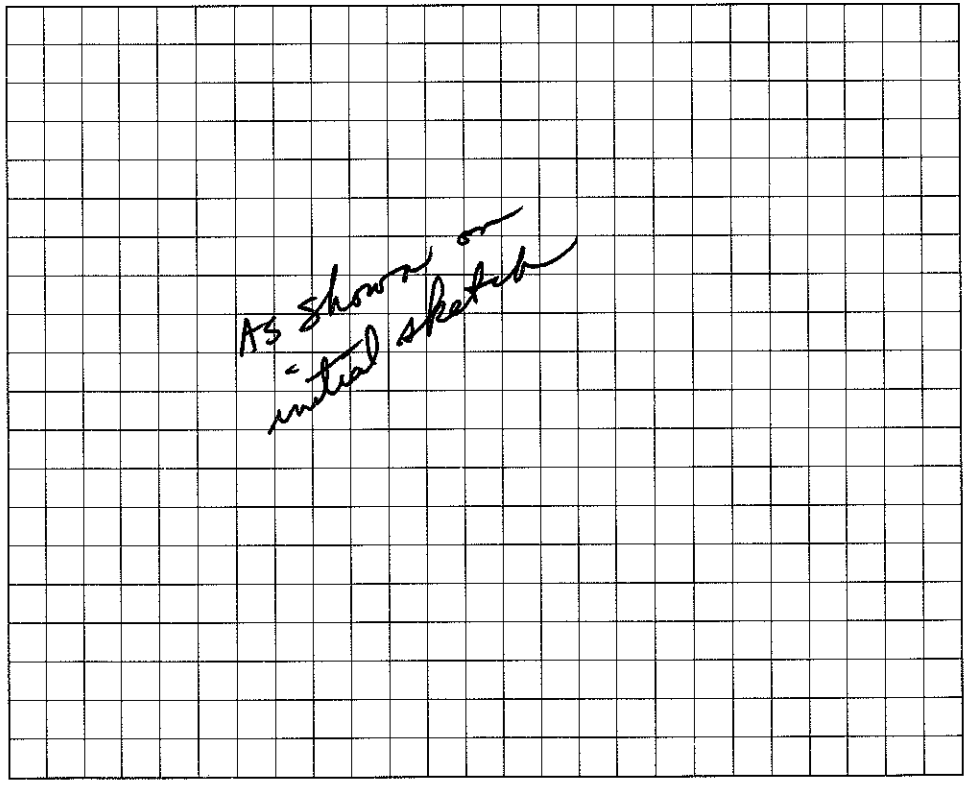

I understand that this permit can be suspended or revoked if any false information is supplied toward securing the permit/any unauthorized changes are made to the site/any unauthorized changes are made in the installation of the system. Improvement Permit is valid for 60 months from date of issuance.

Signed: _____

Improvement Permit by: David R. Hinson IRS date 7/1/93

Existing System Inspection by: _____ date _____

Installed by: _____

Certificate of Completion by: David R. Hinson IRS date 7/13/93

Operation Permit by: _____ date _____

HEALTH DEPT. COPY: WHITE INSPECTION COPY (FINAL): GREEN OWNER COPY (FINAL): YELLOW INSPECTION COPY (INITIAL): PINK OWNER COPY (INITIAL): GOLD