9:30

IREDELL COUNTY HEALTH DEPARTMENT

STATESVILLE 704-878-5305 — MOORESVILLE 704-664-5281

IMPROVEMENT PERMIT / AUTHORIZATION TO CONSTRUCT / OPERATION PERMIT / EXISTING SYSTEM INSPECTION

PERMIT# No PIN# 4636-70-4004 DATE 9/18/02

OWNER OR CONTRACTOR Russ Thompson PHONE: Business 704-361-5160 Home

ADDRESS 116 Mainview Dr. Mooresville, NC. 28117

LOCATION 1100 TL Statts Rd. TL 2ND Commodore Lp. TL Mainview, ▯116 on (L) toward other Commodore Lp.

SUBDIVISION Commodore BLOCK / SECTION 2 LOT 238-239 LOT AREA ~.56AC SITE CLASS PS DESIGN FLOW 240 L.T.A.R. .3

Septic Tank: 1000 Gallons; STB 794 Date 7-8-02

Pump Tank: 1000 Gallons; PT 283 Date 8-5-02

Pump Make: Model Serial No.

Nitrification Field: No Fields 1 Square Feet 900 Linear Feet 300

No Lines 3@100' Trench Width 3' Max Trench Bottom Depth 3' Gravel Depth 12"

(X) New System ( ) Repair System Type: I, (II), III, IV, V, VI

System Description: PM → CONVENTIONAL

Repair System Description: SOME - PABPS

Maintenance Agreement Required: ☐ Yes ☒ No

☒ House/Mod. Home No. Bedrooms 2

☐ Mobile Home No. Bathrooms 2

☐ Business No. Employees

☐ Other


☐ Slab ☒ Crawl Space ☐ Basement w/plumbing ☐ Basement wo/plumbing

Water Supply: ☐ Individual ☐ Public ☒ Community CORRIHER

Comments/Conditions: Plumbing backing up; very slow to drain

Comments/Conditions: Lines checked & tanks checked 10/7/2002. MD

(NOT TO SCALE) INITIAL SITE SKETCH

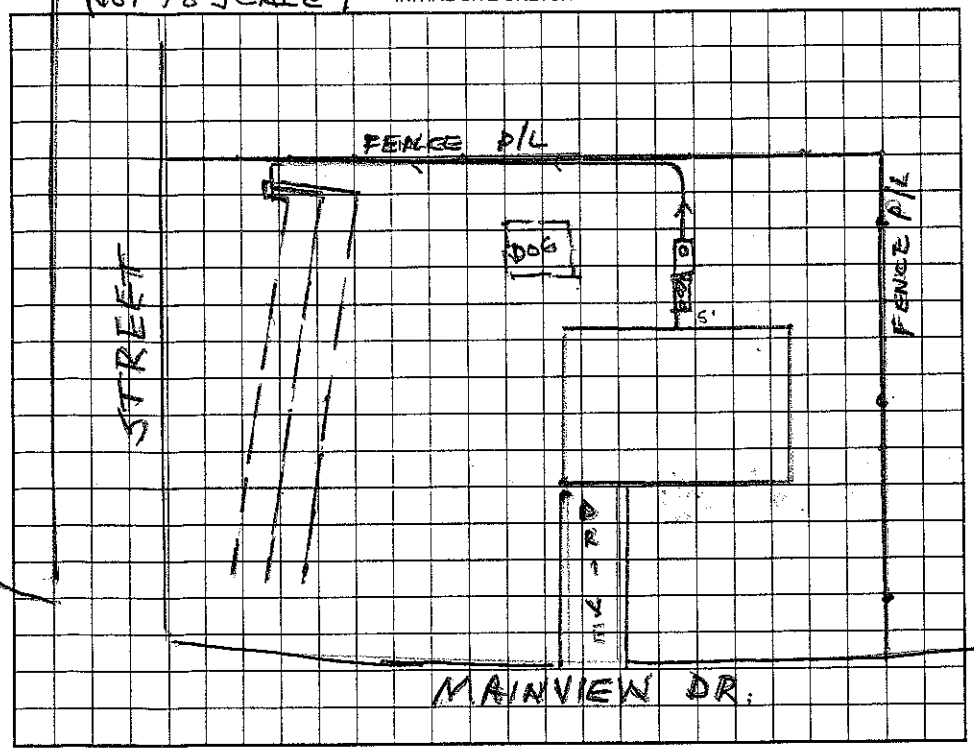

AS BUILT SKETCH

Permit can be suspended or revoked if any false information is supplied toward securing the permit/any unauthorized changes are made to the site/any unauthorized changes are made in the installation of the system. Improvement Permit with plat valid without expiration. Improvement Permit with site plan valid for sixty months. Authorization to Construct is valid for a period equal to that of Improvement Permit – not to exceed sixty months.

Signed: [signature] date 9-23-02 Installed by: Richard Abernathy

Improvement Permit by: Wesley Sparks R.S. date 9/18/02 Operation Permit by: Wesley Sparks R.S. date 12/12/05

Authorization to Construct by: Wesley Sparks R.S. date 9/18/02 Existing System Inspection by: date

HEALTH DEPT. COPY: WHITE OWNER COPY (FINAL): YELLOW OWNER COPY (INITIAL): PINK