10:30

IREDELL COUNTY HEALTH DEPARTMENT

STATESVILLE 704-878-5305 ☒ MOORESVILLE 704-664-5281

IMPROVEMENT PERMIT / AUTHORIZATION TO CONSTRUCT / OPERATION PERMIT / EXISTING SYSTEM INSPECTION

PERMIT # _____ PIN # 4636 70 4067 DATE June 27, 2012

OWNER or APPLICANT Steve Martin PHONE: Business _____ Home: 704-682-3963

OWNER or APPLICANT ADDRESS 3701 Stateline Rd Kansas City MO 64111

LOCATION / DIRECTIONS Brawley Sch Rd TL Stutts TL Commodore TR Mainview on right

SUBDIVISION Commodore Peninsula BLOCK / SECTION _____ LOT # 237 LOT AREA .23 Ac. DESIGN FLOW 360 gpd L.T.A.R. .3 gpd/ft²

Septic Tank Existing Gallons: STB _____ Date _____

Pump Tank _____ Gallons: P T _____ Date _____

Pump Make _____ Model _____ Serial # _____

Nitrification Field No Fields 1 No Lines 2 Linear Feet 68

Trench Width 24" Max. Trench Bottom Depth 36" Gravel Depth NA ☒ GRAVITY ☐ PRESSURE

☐ New System ☐ Repair ☒ Expansion System Type I II (III) IV V VI

System Description: PPBPS

Repair System Description: PPBPS max. feasible rule A945*

Maintenance Agreement Required ☐ YES ☐ NO

☒ Residence No. Bedrooms 3 ☐ Business No. Persons _____ ☐ Other No. Employees _____ ☐ Slab ☒ Crawl Space ☐ Basement w/plumbing ☐ Basement w/o plumbing

Water Supply: ☐ Private ☐ Public ☒ Community

Comments / Conditions - Portion of patio to be removed for supply
- Install D-Box to feed 4 existing lines plus 2 new lines
- Remove shed off existing lines

Comments / Conditions * min. 1 Bd. Repair designed for expansion
Property Recorded 1962

INITIAL SITE SKETCH

- Septic line 5' from property line allowed

See Plan from

Gollans Soil & Environmental Services, PA.

Approved by ICHD

Pre construct Meeting Required

AS BUILT SKETCH

7/3/12 Cheated new Panel line 68'
Center feed
Distribution box 11ft From House
Edge of Dist box lines up with stairs
Not Under patio

Permit can be suspended or revoked if any false information is supplied toward securing the permit / any unauthorized changes are made to the site / any unauthorized changes are made in the installation of the system.

☐ *IMPROVEMENT PERMIT w / plat valid without expiration.* ☒ *IMPROVEMENT PERMIT w / site plan valid for 60 mos.* ☒ *AUTHORIZATION TO CONSTRUCT valid for period equal to IMPROVEMENT PERMIT-not to exceed 60 mo.*

Owner / Applicant Signature: Steve M Date 6-28-12

Improvement Permit by: Judy McNeill Date 6-27-12

Authorization to Construct by: Judy McNeill Date 6-27-12

YOU SHOULD CONTACT A LOCATOR SERVICE PRIOR TO ANY EXCAVATION.

Installed by: Richard Abernathy RS.

Operation Permit by: Mauri Date: 7/3/12

Existing System Inspected by: _____ Date: _____

WHITE COPY Environmental Health YELLOW COPY (Final) Owner / Applicant PINK COPY (Initial) Owner / Applicant

05/21/2012 09:30 7046623239 MOORESVILLE ENV PAGE 01/01

Commodore Peninsula Lot # 112 Mainview Drive Mooresville 5' off Property Line Jarod Lentz

STATESVILLE 704-878-5305 MOORESVILLE 704-664-5281

IREDELL COUNTY HEALTH DEPARTMENT

IMPROVEMENT PERMIT / CERTIFICATE OF COMPLETION / OPERATION PERMIT / EXISTING SYSTEM INSPECTION

PROPERTY DESCRIPTION NO. 17593 DATE May 10, '94 TAX MAP NO. 2C6A237 4636-70-4067 Watershed: ☑ Yes ☐ No LN

OWNER OR CONTRACTOR Jay Young PHONE: Business 875-8238 Home

ADDRESS PO Box 9920 Huntersville

LOCATION 1100 TL 4112 TL 2nd 1212 (Commodore Loop) TL Mainview on left 2nd lot from jct w/ Commodore Loop

SUBDIVISION Commodore Pen. BLOCK / SECTION LOT 237 LOT AREA ~10,000 ft SITE CLASS PS * DESIGN FLOW 240 gpd L.T.A.R. .3

☑ New System ☐ Repair System Type: I, (II), III, IV, V, VI

System Description: gravity conventional

Repair System Description: same or LP PPBPS

Maintenance Agreement Required: ☐ Yes ☑ No

☑ House/Mod. Home ☐ Mobile Home ☐ Business ☐ Other

No. Bedrooms 2 No. Bathrooms 1½ No. Employees

Water Supply: ☐ Individual ☑ Community ☐ Public

Septic Tank: 1000 Gallons; STB 794 Date 6-28-94

Pump Tank: Gallons; PT Date

Pump Make: Model Serial No.

Nitrification Field: No Fields 1 Square Feet 800 Linear Feet 267


No Lines 4 Trench Width 36" Max Trench Bottom Depth 36" Gravel Depth 12"

☐ Slab ☑ Crawl Space ☐ Basement w/plumbing ☐ Basement wo/plumbing


Comments: lot recorded in mid 60's; not subject to 100% repair area requirement.

Comments: 10/11/94 3 lines ok'd.

INITIAL SITE SKETCH

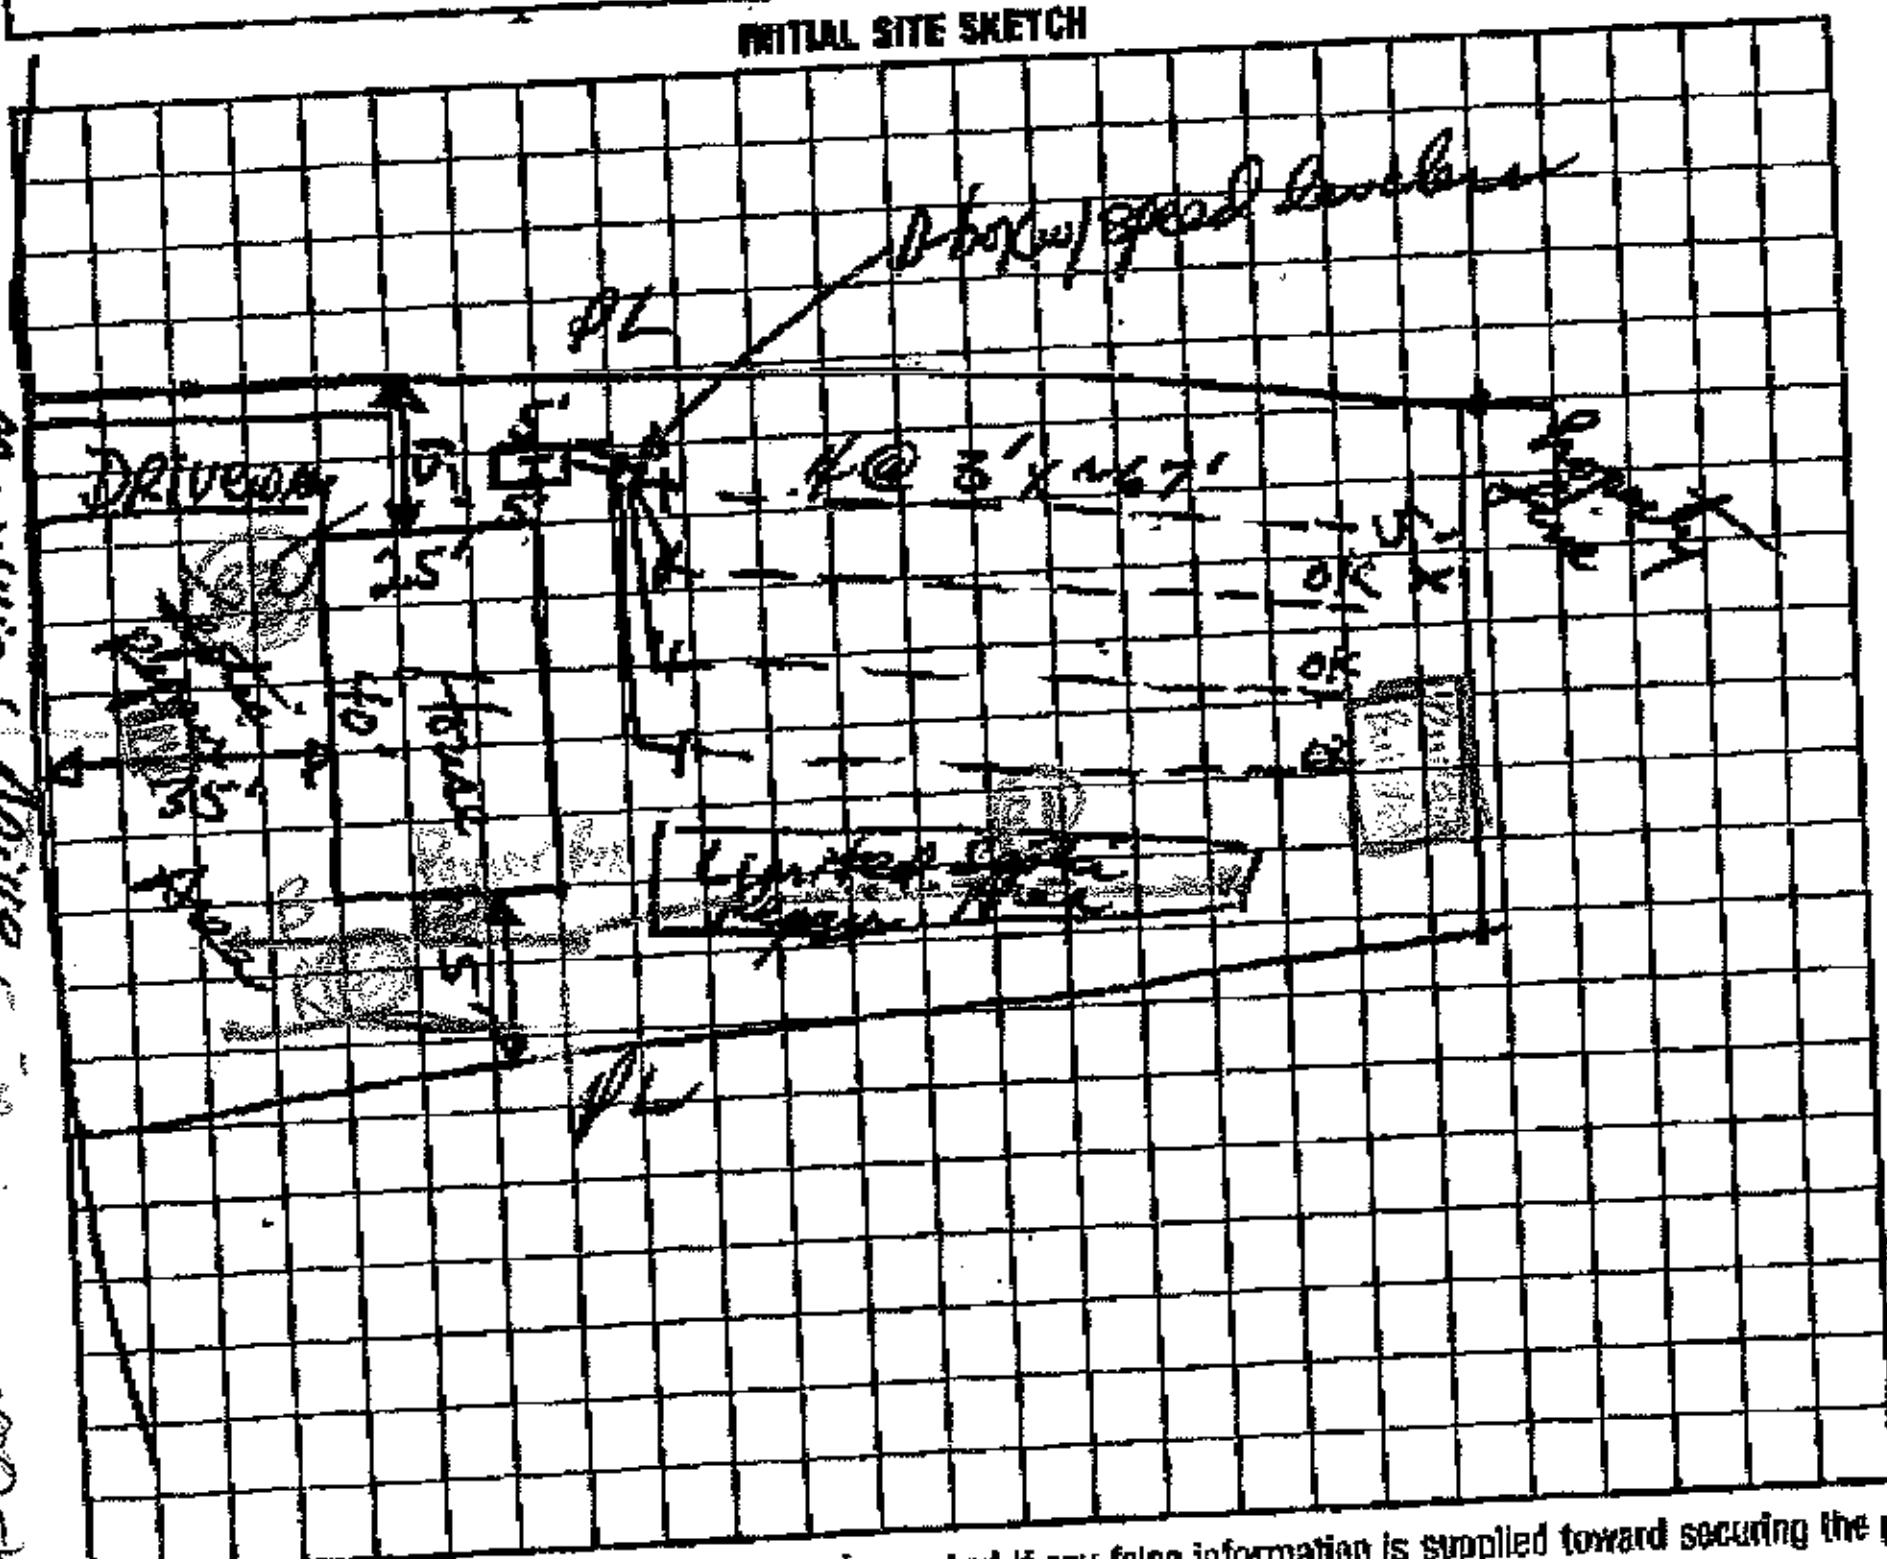

AS BUILT SKETCH

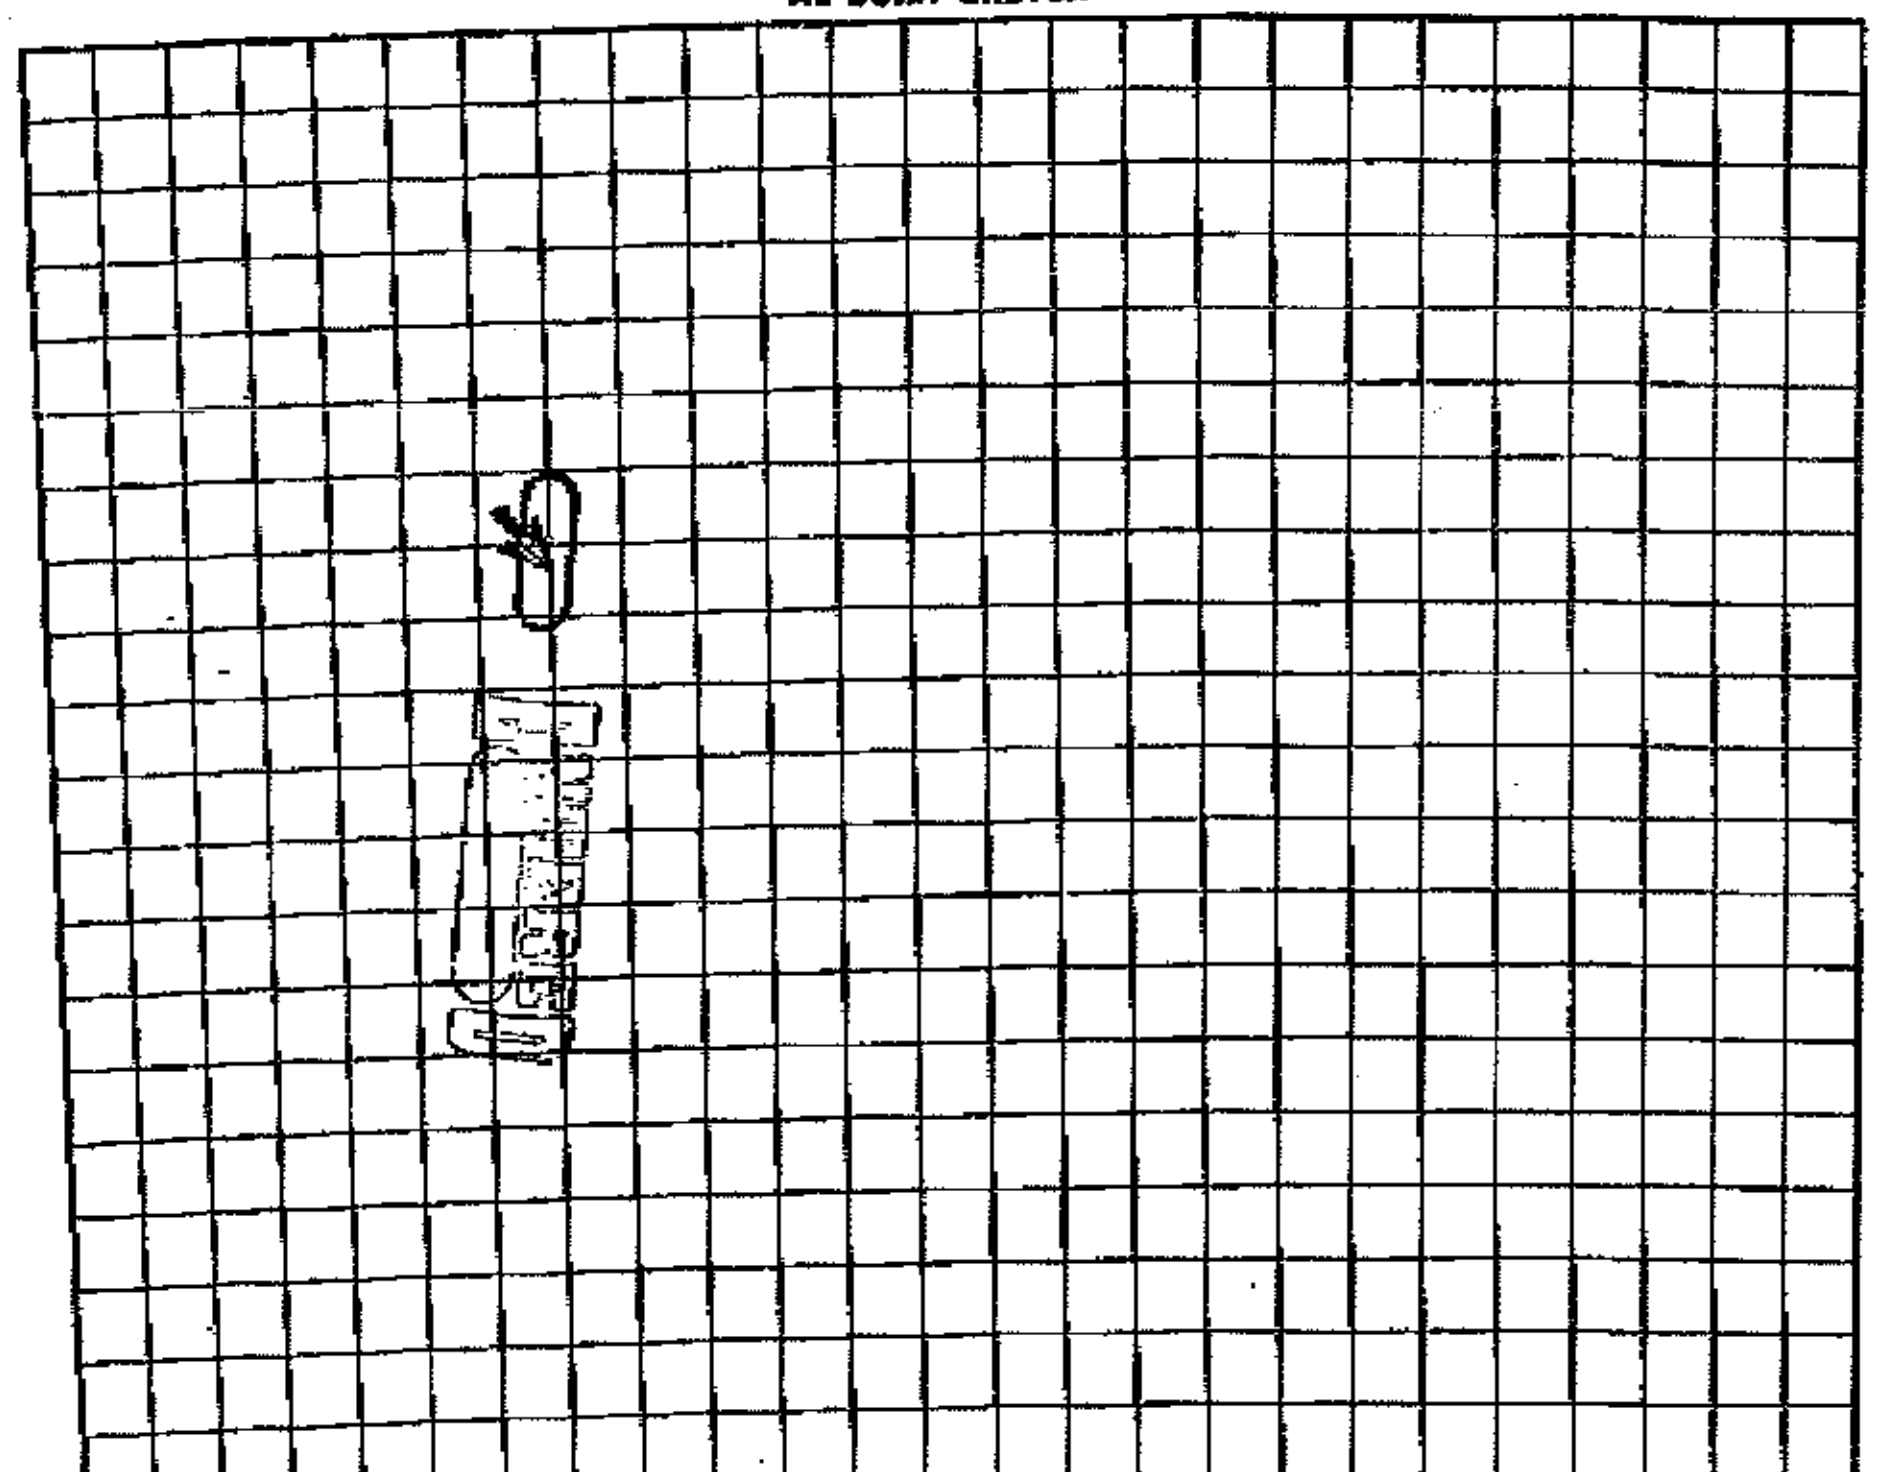

3000-1400

I understand that this permit can be suspended or revoked if any false information is supplied toward securing the permit/any unauthorized changes are made to the site/any unauthorized changes are made in the installation of the system.

Improvement Permit is valid for 60 months from date of issuance.

Signed: [signature] date 5/10/94

Improvement Permit by: [signature] RS date

Existing System Inspection by:

Installed by: Orbison Const. Co.

Certificate of Completion by: Wesley Sparks RS. date 11/12/94

Operation Permit by: date

HEALTH DEPT. COPY: WHITE INSPECTION COPY (FINAL): GREEN OWNER COPY (FINAL): YELLOW INSPECTION COPY (INITIAL): PINK OWNER COPY (INITIAL): GOLD