IREDELL COUNTY HEALTH DEPARTMENT

STATESVILLE 704-878-5305 MOORESVILLE 704-664-5281

IMPROVEMENT PERMIT / CERTIFICATE OF COMPLETION / OPERATION PERMIT / EXISTING SYSTEM INSPECTION

PROPERTY DESCRIPTION NO. 17593 DATE May 10, 94 TAX MAP NO. 2-6A-237 4436-70-4067 Watershed: ☑ Yes ☐ No

OWNER OR CONTRACTOR Jay Young PHONE: Business 875-8238 Home LN

ADDRESS PO Box 9920 Huntsville

LOCATION 100 TL 112 TL 2nd 1212 (Commodore Loop) TL Mainview on left 2nd lot from jct w/ Commodore Loop

SUBDIVISION Commodore Pen. BLOCK / SECTION LOT 237 LOT AREA ~10,000 ft² SITE CLASS: PS * DESIGN FLOW 240 gpd L.T.A.R. .3

Septic Tank: 1000 Gallons; STB 794 Date 6-28-94

Pump Tank: Gallons; PT Date

Pump Make: Model Serial No.

Nitrification Field; No Fields 1 Square Feet 800 Linear Feet 267

No Lines 4 Trench Width 36" Max Trench Bottom Depth 36" Gravel Depth 12"

☑ New System ☐ Repair System Type: I, II, III, IV, V, VI

System Description: gravity conventional

Repair System Description: sand or LA PBPS

Maintenance Agreement Required: ☐ Yes ☑ No

☑ House/Mod. Home No. Bedrooms 2

☐ Mobile Home No. Bathrooms 1½

☐ Business No. Employees

☐ Other


☐ Slab ☑ Crawl Space ☐ Basement w/plumbing ☐ Basement wo/plumbing

Water Supply: ☐ Individual ☑ Community ☐ Public

Comments: Lot recorded in mid 60's; not subject to 100% repair area requirement.

Comments: 10/11/94 3 lines ok'd.

INITIAL SITE SKETCH

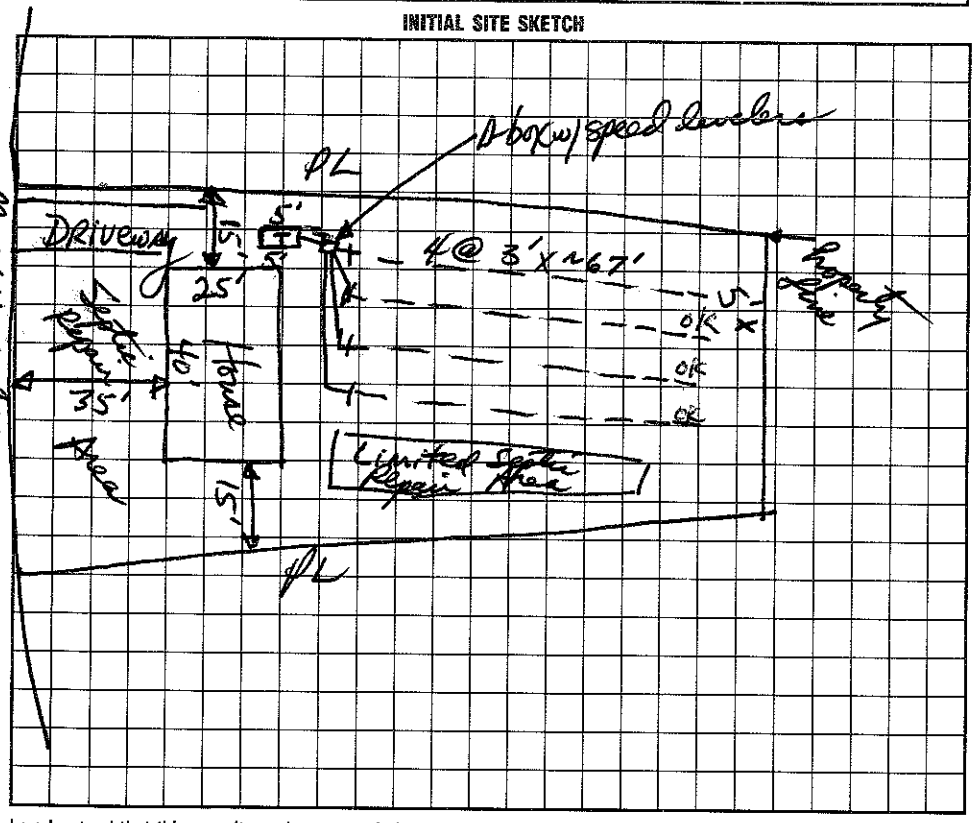

AS BUILT SKETCH

I understand that this permit can be suspended or revoked if any false information is supplied toward securing the permit/any unauthorized changes are made to the site/any unauthorized changes are made in the installation of the system. Improvement Permit is valid for 60 months from date of issuance.

Signed:

Improvement Permit by: Derek R. Hinson IRS date 5/10/94

Existing System Inspection by: date

Installed by: Orlison Const. Co.

Certificate of Completion by: Wesley Sparks RS. date 11/12/94

Operation Permit by: date

HEALTH DEPT. COPY: WHITE INSPECTION COPY (FINAL): GREEN OWNER COPY (FINAL): YELLOW INSPECTION COPY (INITIAL): PINK OWNER COPY (INITIAL): GOLD