Dashboard 928-2016 2007 2:00

IREDELL COUNTY HEALTH DEPARTMENT

STATESVILLE 704-878-5305 MOORESVILLE 704-664-5281

IMPROVEMENT PERMIT / AUTHORIZATION TO CONSTRUCT / OPERATION PERMIT / EXISTING SYSTEM INSPECTION

PERMIT# 113721 PIN# 4636706081 DATE 12-1-06

OWNER OR APPLICANT Georgjina Brustmaker PHONE: Business 704-819-6630 Home

ADDRESS 9214 Culcaith Rd Huntersville 28078

LOCATION Brawley School Rd TL Stutts TL Commodore Lp on corner of Mainview

SUBDIVISION Commodore Peninsula BLOCK / SECTION LOT 181-182 LOT AREA .47 Ac SITE CLASS. PS DESIGN FLOW 360 gpd L.T.A.R. .3 gpd/ft²

Septic Tank: 1000 Gallons; STB 825 Date 5-29-07

Pump Tank: Gallons; PT Date

Pump Make: Model Serial No.

Nitrification Field: No Fields 1 Square Feet 1200 Linear Feet 300

No Lines 3@100' Trench Width 36" Max Trench Bottom Depth 36" Gravel Depth NA

☒ New System ☐ Repair ☐ Expansion System Type: I II III IV V VI

System Description: 25% reduction gravity

Repair System Description: LP PPBPS

Maintenance Agreement Required: ☐ Yes ☒ No

☒ House/Mod. Home ☐ Mobile Home ☐ Business ☐ Other

No. Bedrooms 3 No. Persons 6 No. Employees


Water Supply: ☐ Individual ☒ Public ☐ Community

☒ Gravity ☐ Pressure ☒ Slab ☒ Crawl Space ☐ Basement w/plumbing ☐ Basement wo/plumbing

Comments:/Conditions: D-Box w/ speed levelers or flow splitter such as Zoeller see site plan for house placement details

Comments:/Conditions: Filter installed in ST

INITIAL SITE SKETCH 1" = 40'

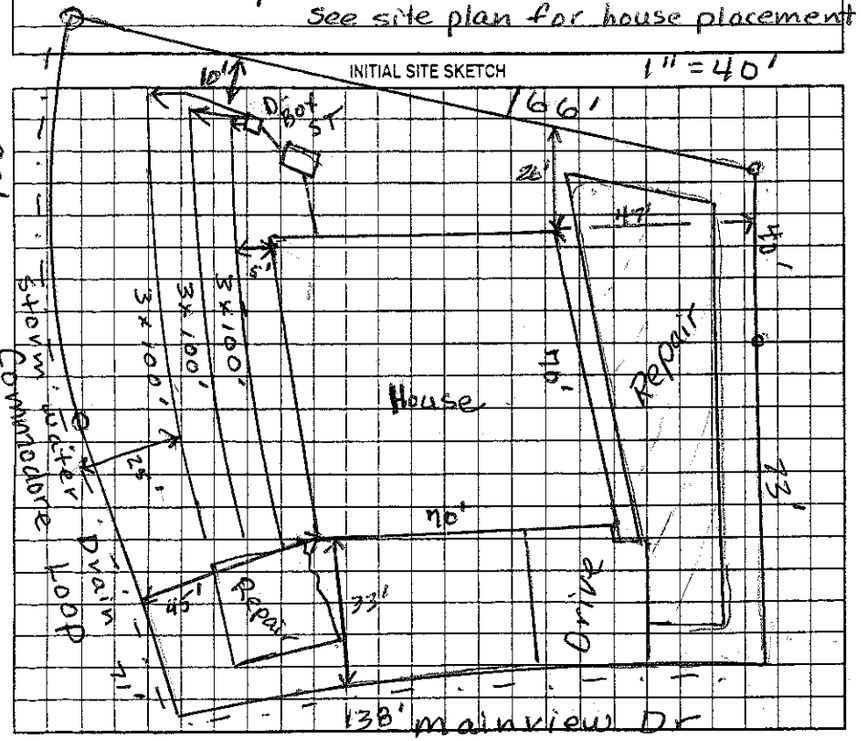

AS BUILT SKETCH

Installed Quick 4 Infiltrator Drainfield As Shown Used 4 Built In Drop Boxes

Permit can be suspended or revoked if any false information is supplied toward securing the permit/any unauthorized changes are made to the site/any unauthorized changes are made in the installation of the system. Improvement Permit with plat valid without expiration ☐ Improvement Permit with site plan valid for sixty months ☒ Authorization to Construct is valid for a period equal to that of Improvement Permit – not to exceed sixty months.

Signed: Georgjina Brustmaker date 12-1-06

Improvement Permit by: Judy Melville date 12-1-06

Authorization to Construct by: Judy Melville date 12-1-06

Installed by: Rowan Septics

Operation Permit by: Mark Dotson date 7/11/07

Existing System Inspection by: date

HEALTH DEPT. COPY: WHITE OWNER COPY (FINAL): YELLOW OWNER COPY (INITIAL): PINK