IREDELL COUNTY HEALTH DEPARTMENT

Statesville Phone TR 3-7271 Mooresville Phone NO 3-1271

PERMIT TO INSTALL SEPTIC TANK

Permit NO._____ Permit Date July 15 1963

Owner Mr. J.R. Trivette Address Kannapolis, N.C.

Installed By Sam Perkins Address Kannapolis N.C.


Location of Property Commodore Peninsula, Lot 46

Tank		Capacity		Length of Lines		Fixtures	
Block	( )	800	( )	150'	( )	No. of Baths	( )
Precast	(X)	900	( )	175'	( )	Dishwasher	( )
1-500gal		1000	( )	200'	( )	Garbage Grdr.	( )
		1100	( )	225'	(X)	Auto-Washer	( )
1-1000gal		1200	( )	250'	( )	Other	
		Other		Other			

NOTIFY HEALTH DEPARTMENT AT LEAST EIGHT HOURS BEFORE TANK IS TO BE INSPECTED.

Final Inspection July 15 1963 Approved (X) Disapproved ( )

Remarks Community Water

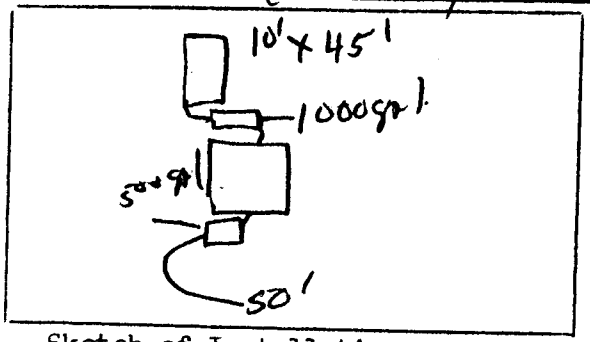

Sketch of Installation

J.M. Seagroves R.S.
Sanitarian