IREDELL COUNTY HEALTH DEPARTMENT

STATESVILLE 704-878-5305 MOORESVILLE 704-664-5281

IMPROVEMENT PERMIT / CERTIFICATE OF COMPLETION / OPERATION PERMIT / EXISTING SYSTEM INSPECTION

PROPERTY DESCRIPTION NO. 12949 DATE June 18, 93 TAX MAP NO. 2G-17-A-7

OWNER OR CONTRACTOR Marty Edwards PHONE ~~Business~~ 463-291-0072 Home

ADDRESS 1040 Amity Hill Rd, Cleveland NC 27013

LOCATION 1100 ± TL 1112 TL Peninsula Ln. on right in Cul-D-Sac

SUBDIVISION Norman Shores BLOCK / SECTION LOT 7 LOT AREA ~ 20,000 ft² SITE CLASS. PS L.T.A.R. .4

Water Supply: ☑ Individual ☐ Community ☐ Public

Septic Tank: 1000 Gallons; STB 782 Date 4/21/93

Pump Tank: Gallons; PT Date

Nitrification Field: No Fields 1 Square Feet Linear Feet 160

No Lines 2 Trench Width 24" Trench Depth ~36" Gravel Depth NA

☑ New System ☐ Repair System Type: I, II, III, IV, V, VI

System Description: Gravity PVBPS

Repair System Description:

Maintenance Agreement Required: ☐ Yes ☑ No

☑ House/Mod. Home Future No. Bedrooms 3

☐ Mobile Home No. Bathrooms 2

☐ Business No. Employees

☐ Other

☐ Slab ☑ Crawl Space ☐ Basement w/plumbing ☐ Basement wo/plumbing

Garbage Disposal: ☐ Yes ☑ No


Auto. Dishwasher: ☑ Yes ☐ No

Auto. Washing Machine: ☑ Yes ☐ No

Other

Comments House construction not started.

INITIAL SITE SKETCH

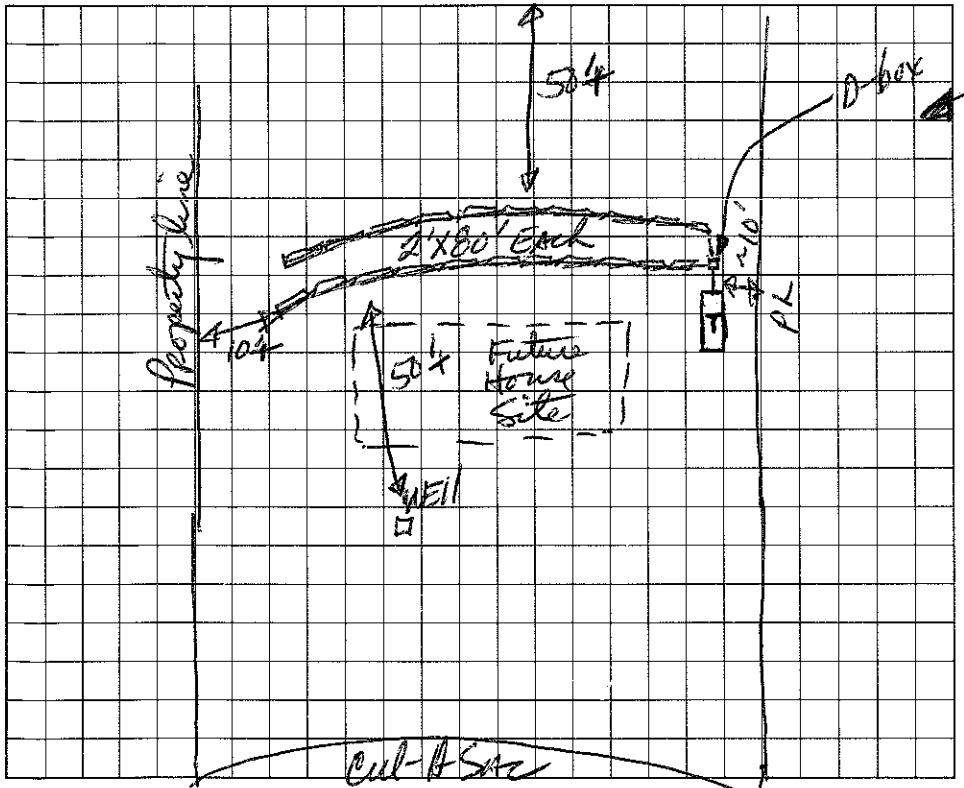

AS BUILT SKETCH

I understand that this permit can be suspended or revoked if any false information is supplied toward securing the permit/any unauthorized changes are made to the site/any unauthorized changes are made in the installation of the system. Improvement Permit is valid for 60 months from date of issuance.

Signed:

Installed by: Richard Abernathy

Improvement Permit by: date

Certificate of Completion by: date

Existing System Inspection by: date

Operation Permit by: D R Hansen IRS date 6/18/93

HEALTH DEPT. COPY: WHITE INSPECTION COPY (FINAL): GREEN OWNER COPY (FINAL): YELLOW INSPECTION COPY (INITIAL): PINK OWNER COPY (INITIAL): GOLD