IREDELL COUNTY HEALTH DEPARTMENT

STATESVILLE 704-878-5305 MOORESVILLE 704-664-5281

Paid 175.00 2130 F

IMPROVEMENT PERMIT / AUTHORIZATION TO CONSTRUCT / OPERATION PERMIT / EXISTING SYSTEM INSPECTION

PERMIT# 100800 PIN# 4636071077 DATE 7-2-2001

OWNER OR CONTRACTOR Ray Dunlap PHONE: Business 968-4900 Home 660-9832

ADDRESS 123 Stover Ln Mooresville, NC 28117

LOCATION Brawley School Rd TL Stutts TL Peninsula TL Hiram TR Stover at end on left

SUBDIVISION Norman Shore BLOCK / SECTION ____ LOT 26 LOT AREA .52 Acre SITE CLASS. PS DESIGN FLOW 360gpd L.T.A.R. .3

Septic Tank: 1000 Gallons; STB 312 Date 10-12-01
Pump Tank: ____ Gallons; PT ____ Date ____
Pump Make: ____ Model ____ Serial No. ____
Nitrification Field: No Fields 1 Square Feet 600' Linear Feet 300'
No Lines 3 Trench Width 36" Max Trench Bottom Depth 36" Gravel Depth N/A

[X] New System [ ] Repair System Type: I, II, III, IV, V, VI
System Description: Gravity -25% Reduction
Repair System Description: Deeded/Platted prior to 1983
Maintenance Agreement Required: [ ] Yes [ ] No

[X] House/Mod. Home [ ] Mobile Home [ ] Business [ ] Other
No. Bedrooms 3 No. Bathrooms 2.5 No. Employees ____
[ ] Slab [ ] Crawl Space [ ] Basement w/plumbing [ ] Basement wo/plumbing


Water Supply: [X] Individual [ ] Public [ ] Community

Comments:/Conditions: Must keep Septic System at least 10' from PL, 5' from house, 50' from lake & 50' From any well. Divert stormwater/surface water away from Drainfield.

Comments:/Conditions: * Very tight lot; must be careful regarding setbacks
* Must obtain well variance from DHHER for well

INITIAL SITE SKETCH

Scale 1:50

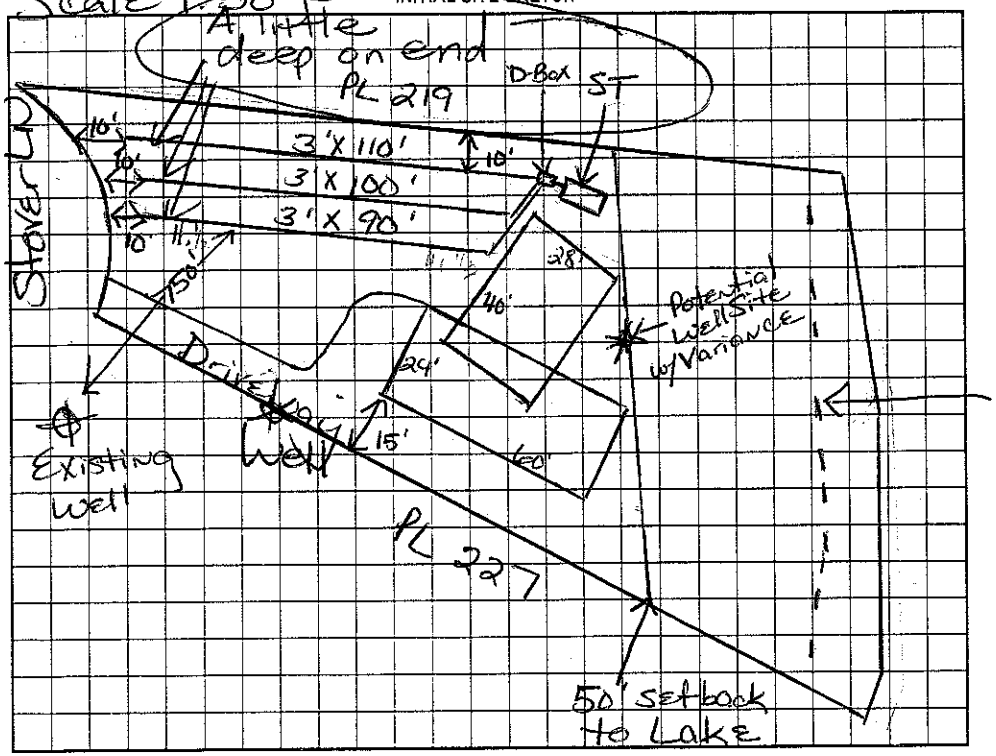

AS BUILT SKETCH

Well Exactly 50' 1/2" to Drainlines

Installed "Plastic Chambers" as drawn

Lake Norman 760 contour

Used Speed levelers!

Permit can be suspended or revoked if any false information is supplied toward securing the permit/any unauthorized changes are made to the site/any unauthorized changes are made in the installation of the system. Improvement Permit with plat valid without expiration. Improvement Permit with site plan valid for sixty months. Authorization to Construct is valid for a period equal to that of Improvement Permit – not to exceed sixty months.

Signed: Ray Dunlap date 7/7/01

Improvement Permit by: Maria H. Dotson RS. date 7/2/2001

Authorization to Construct by: Maria H. Dotson RS. date 7/2/2001

Installed by: Larry Beam Grading

Operation Permit by: Maria H. Dotson RS. date 11/19/2001

Existing System Inspection by: ____ date ____

HEALTH DEPT. COPY: WHITE OWNER COPY (FINAL): YELLOW OWNER COPY (INITIAL): PINK