4636 71 1909

IREDELL COUNTY HEALTH DEPARTMENT

10578

(SEPTIC TANK) IMPROVEMENTS PERMIT AND CERTIFICATE OF COMPLETION
(Ground Absorption Sewage Disposal System -- G. S. Chapter 130-Article 13C)

OWNER OR CONTRACTOR Mosley Construction DATE May 6, '91 PERMIT NO. 26-17-A-37

PHONE: Business _____ Home _____

LOCATION 1100 Tr 1112 (Statts Rd.) Tr Woodstream at end on left S. R. No. _____

SUBDIVISION NAME Norman Woods LOT NO. 37 SECTION OR BLOCK NO. _____


House (✓) Mobile Home ( ) Business ( ) Other _____

No. Bedrooms 3 No. Bathrooms 2

Garbage Disposal Unit	Yes ( )	No (✓)	Character & Porosity of Soil	PS clay
Auto. Dishwasher	Yes (✓)	No ( )	Percolation Rate	2.35
Auto. Wash. Machine	Yes (✓)	No ( )	Topography	2%
Site ~~Suitable~~	PS	Yes ( )	No ( )	Depth to Water Table	4' +
				Rock or other impervious formations	none obs.

Lot Area Existing - 20000 ft²

_____ Basement with Plumbing _____ Basement without Plumbing ✓ No Basement

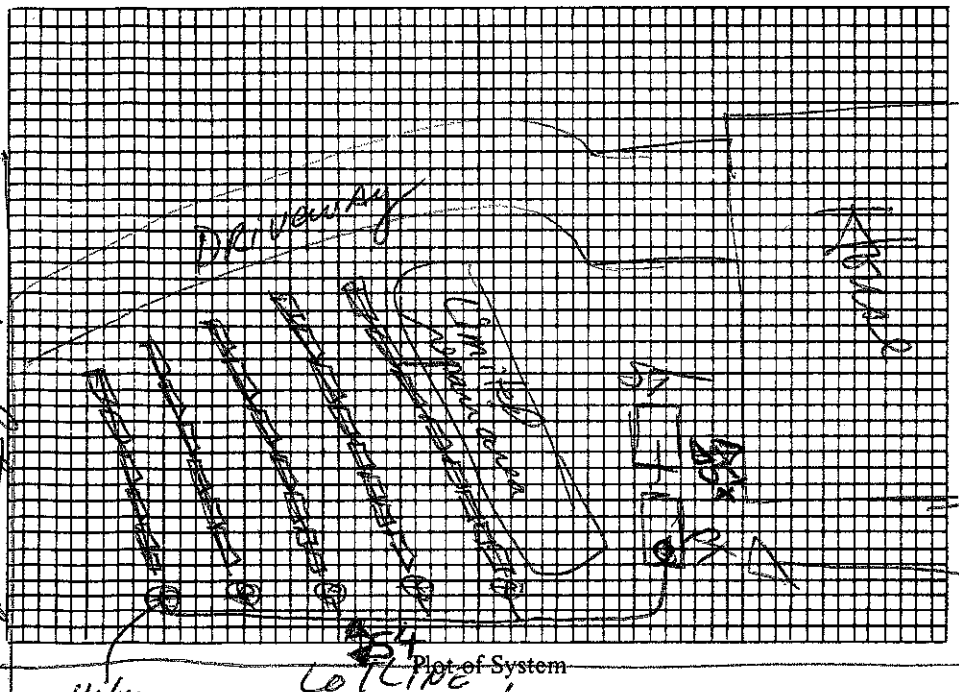

Size of Tank 1000 gal. 1000

Nitrification Field:
No. of Lines 5
Sq. Ft. _____ Linear Ft. 150
Depth of Stone in Lines 16" + Gravel

Water Supply: Individual ( )
Public ( )

Installed by Bob MacLeod
pump replaced by S&D plumbing
I understand and agree to install septic tank system as specified on this Improvements Permit.

Signed: _____

IMPROVEMENTS PERMIT BY BKH

COMMENTS: Drainfield and tanks installed 6-29-90.
Checked alarm, replaced pump and repressurized drainfield.
Septic tank may be turned differently than sketched due to it being approx 1 year since it was installed.

CERTIFICATE OF COMPLETION BY Original Permit DATE 5/6/91

EXISTING SYSTEM CHECKED BY: _____ DATE _____

CONSTRUCTION MUST COMPLY WITH ALL OTHER APPLICABLE STATE AND LOCAL REGULATIONS.

Permit is VOID if any unauthorized changes are made in installation of system and/or if any false information is supplied in making Improvements Permit.

Health Dept. Copy: White Inspection Dept. Copy: Yellow Sanitarian's Copy: Pink Owner's Copy: Gold