IREDELL COUNTY HEALTH DEPARTMENT

STATESVILLE 704-878-5305 MOORESVILLE 704-664-5281

IMPROVEMENT PERMIT / AUTHORIZATION TO CONSTRUCT / OPERATION PERMIT / EXISTING SYSTEM INSPECTION

PERMIT# 137094 PIN# 4636 72 0223 DATE 2/12/07

OWNER OR APPLICANT Carolina Builders PHONE: Business 704-902-2057 Home 704-631-8102

ADDRESS

LOCATION 1100 TL Shutts Rd TL Woodstream to rear on (R) in Curve

SUBDIVISION Norman Woods BLOCK / SECTION LOT 45 LOT AREA .48AC SITE CLASS. AS DESIGN FLOW 360 L.T.A.R. .25

Septic Tank: 1000 Gallons; STB 283 Date 4/30/07
Pump Tank: 1000 Gallons; PT 17 Date 5/21/07
Pump Make: Gandels Model ~~PUMP/LEO~~ SP/H
Nitrification Field: No Fields 1 Square Feet 720 Linear Feet 240
No Lines 4@60' Trench Width 3' Max Trench Bottom Depth 36"

[X] New System ☐ Repair ☐ Expansion System Type: I II III (IV) V VI
System Description: LP- PPBPS
Repair System Description: 283 LOT
Maintenance Agreement Required: [X] Yes ☐ No

[X] House/Mod. Home No. Bedrooms 3
☐ Mobile Home No. Persons
☐ Business No. Employees
☐ Other


Water Supply: [X] Individual ☐ Public ☐ Community

Gravel Depth No ☐ Gravity [X] Pressure ☐ Slab [X] Crawl Space ☐ Basement w/plumbing ☐ Basement wo/plumbing

Comments:/Conditions:

Comments:/Conditions:

INITIAL SITE SKETCH

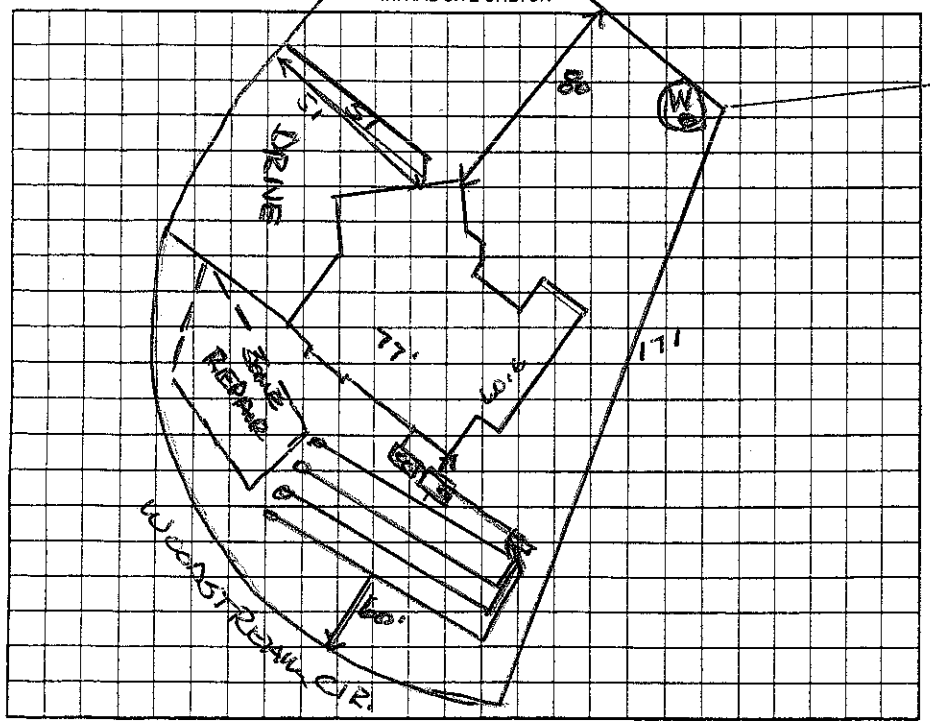

AS BUILT SKETCH

Tanks & Lines & pressure head checked 6/29/07 JK

Permit can be suspended or revoked if any false information is supplied toward securing the permit/any unauthorized changes are made to the site/any unauthorized changes are made in the installation of the system. Improvement Permit with plat valid without expiration. ☐ Improvement Permit with site plan valid for sixty months ☑ Authorization to Construct is valid for a period equal to that of Improvement Permit – not to exceed sixty months.

Signed: [signature] date 2/27/07 Installed by: C+S Grading

Improvement Permit by: Wesley Sparks RS date 2/12/06 Operation Permit by: Wesley Sparks RS date 9/14/07

Authorization to Construct by: Wesley Sparks RS. date 2/12/06 Existing System Inspection by: date

HEALTH DEPT. COPY: WHITE OWNER COPY (FINAL): YELLOW OWNER COPY (INITIAL): PINK