IREDELL COUNTY HEALTH DEPARTMENT

Statesville Office (704) 878-5305 Mooresville Office (704) 660-3625 PERMIT # 216356

IMPROVEMENT PERMIT / AUTHORIZATION TO CONSTRUCT / OPERATION PERMIT / EXISTING SYSTEM

PIN # 4636 720 305

APPLICANT: Michael Boutot APPLICANT ADDRESS: Bridal Path Rd Mooresville, NC 28117

SITE ADDRESS: 194 Woodstream Circle Mooresville NC PHONE: 704 289 4132 ALT. PHONE:

SITE DIRECTIONS: Brawley School Rd TL Stotts TL Woodstream 239 on right

SUBDIVISION: Norman Woods SECTION: — LOT # 46 LOT AREA: .47 Acre DESIGN FLOW: 480 gpd L.T.A.R.: .3

Septic Tank	1000	(gal)	STB	825	Date	10-7-15	☒ New System	☐ Repair	☐ Expansion	System Type: I II III IV V VI	☒ Residence	No. Bedrooms	4	Water Supply	
Pump Tank		(gal)	PT		Date		System Description:	Gravity – ~~35~~ PPBPS			☐ Business	No. Persons	8	☒ Private	
Pump Make			Model		Serial #		Repair System Description:	Limited (lot deeded 1968)			☐ Other	No. Employees		☐ Public	
# Nitrification Fields	1		# Lines	6	Linear Ft:	270'	Maintenance Agreement Required:	☐ YES	☒ NO		☐ Slab	☒ Crawl Space		☐ Community	
Trench Width	24"		Max. Trench Bottom Depth	36"	Gravel Depth	N/A	☒ GRAVITY	☐ PRESSURE			☐ Basement w/plumbing	☐ Basement w/o plumbing			


Comments / Conditions: 2/12/16 Reviewed Floor plans, in Compliance with Septic plan
8/18/16 Checked ST & some drainlines
8/19/16 Checked other lines & boxes

* Lot deeded 1968

INITIAL SITE SKETCH

See attached/approved plan by Michael Athanas & Associates dated 2/1/16

AS BUILT SKETCH

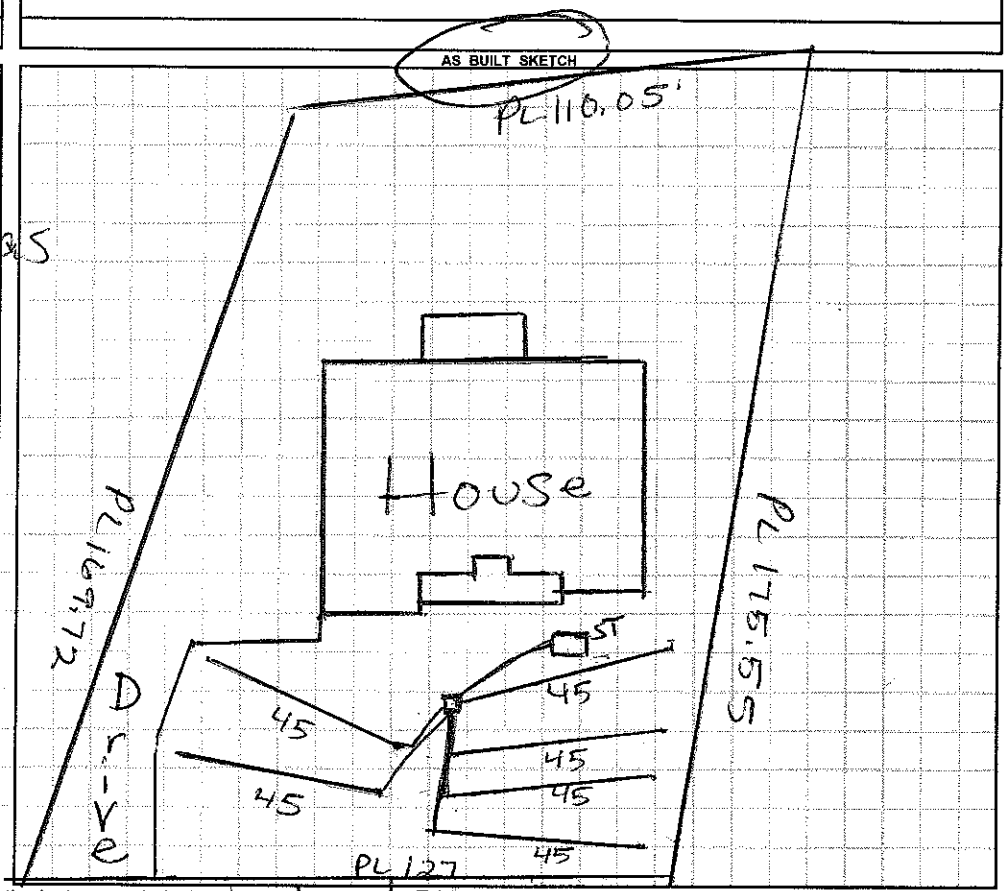

Permit can be suspended or revoked if any false information is supplied toward securing the permit / any unauthorized changes are made to the site / any unauthorized changes are made in the installation of the system. **CONTACT A LOCATOR SERVICE PRIOR TO ANY EXCAVATION**

☐ **IMPROVEMENT PERMIT** *with plat valid without expiration.* ☐ **IMPROVEMENT PERMIT** *with site plan valid for 60 mos.* ☐ **AUTHORIZATION TO CONSTRUCT** *valid for period equal to IMPROVEMENT PERMIT--not to exceed 60 mo.*

Owner / Applicant Signature: Date: 2/12/16 Installed by: Rowan Septic

IMPROVEMENT PERMIT by: Maria Dolan RS Date: 2/10/16 OPERATION PERMIT by: Maria Dolan RS Date: 8/19/16

AUTHORIZATION TO CONSTRUCT by: Maria Dolan RS Date: 2/12/16 Existing System Inspected by: Date:

Health Dept. Copy - WHITE Applicant (Final Approval) - YELLOW Applicant (Conditional Approval) - PINK