IREDELL COUNTY HEALTH DEPARTMENT

STATESVILLE 704-878-5305 ⊘ MOORESVILLE 704-664-5281

IMPROVEMENT PERMIT / AUTHORIZATION TO CONSTRUCT / OPERATION PERMIT / EXISTING SYSTEM INSPECTION

PERMIT# Repair PIN# DATE 12/17/01

OWNER OR CONTRACTOR Richard Wolff PHONE: Business Home 704 662 0821

ADDRESS 187 Wood stream Rd, Mooresville 28117

LOCATION Brawley Sch, TL Stutts, TL Wood stream on Lt. 187 Wood stream

SUBDIVISION Norman Woods BLOCK / SECTION LOT 29+30 LOT AREA SITE CLASS. PS DESIGN FLOW 480 L.T.A.R. —

Septic Tank: 1000 Gallons: STB Date

Pump Tank: Gallons; PT Date

Pump Make: Model Serial No.

Nitrification Field: No Fields 2 Square Feet Linear Feet

No Lines Trench Width DR Alt Trench Bottom Depth Gravel Depth —

☐ New System ☒ Repair System Type: I. II. (III.) IV. V. VI

System Description:

Repair System Description: 25% Reduction Bed+Line

Maintenance Agreement Required: ☐ Yes ☒ No

☒ House/Mod. Home No. Bedrooms 5

☐ Mobile Home No. Bathrooms 3.5

☐ Business No. Employees

☐ Other

☐ Slab ☒ Crawl Space ☒ Basement w/plumbing ☐ Basement wo/plumbing


Water Supply: ☒ Individual ☐ Public ☐ Community

Comments:/Conditions:


* Pump out, Crush + Fill in Existing Tank 1

Comments:/Conditions:

INITIAL SITE SKETCH

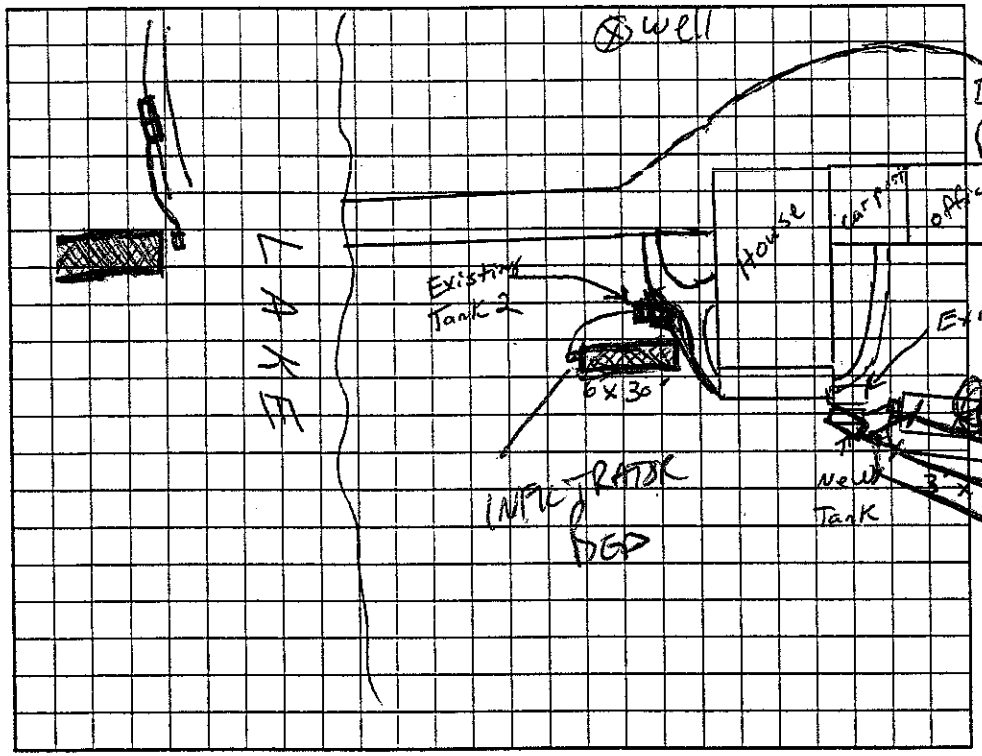

AS BUILT SKETCH

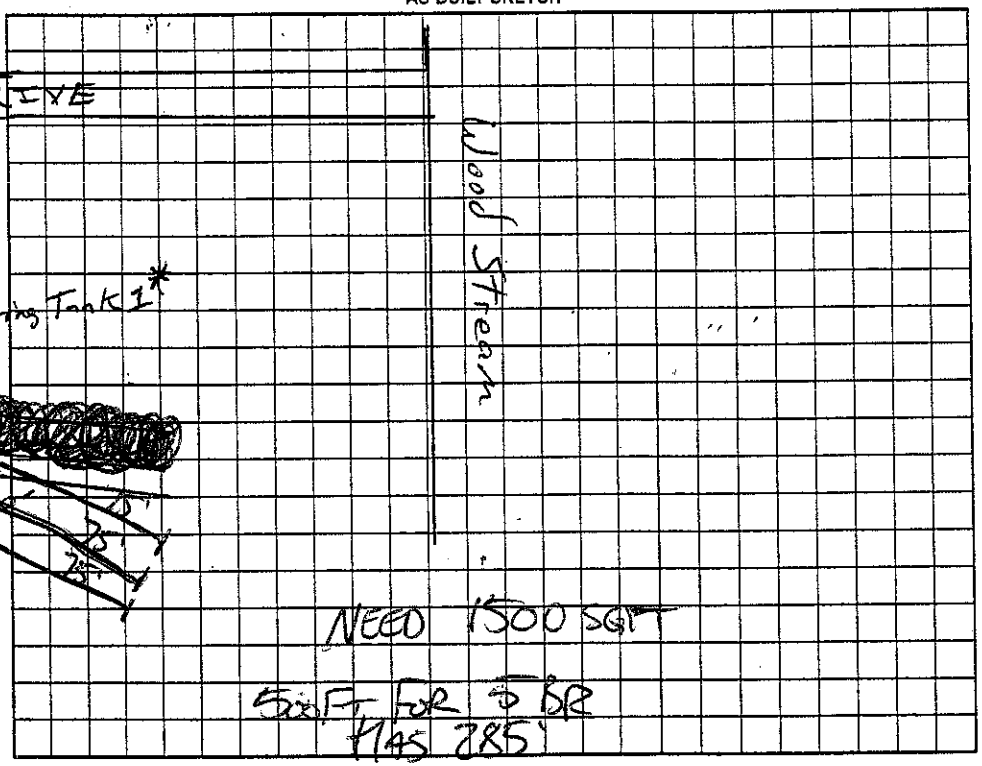

Permit can be suspended or revoked if any false information is supplied toward securing the permit/any unauthorized changes are made to the site/any unauthorized changes are made in the installation of the system. Improvement Permit with plat valid without expiration. Improvement Permit with site plan valid for sixty months. Authorization to Construct is valid for a period equal to that of Improvement Permit – not to exceed sixty months.

Signed: Susan D. Wolff date

Improvement Permit by: RSI date 12/17/01

Authorization to Construct by: RSI date 12/17/01

Installed by:

Operation Permit by: date

Existing System Inspection by: date