IREDELL COUNTY HEALTH DEPARTMENT

STATESVILLE 704-878-5305 MOORESVILLE 704-664-5281

IMPROVEMENT PERMIT / CERTIFICATE OF COMPLETION / OPERATION PERMIT / EXISTING SYSTEM INSPECTION

PROPERTY DESCRIPTION NO. 20470 DATE March 27, 95 TAX MAP NO. 2617 A 25 Watershed: ☑ Yes ☐ No

OWNER OR CONTRACTOR Douglas W. Barkley PHONE: Business 463e-72-1908 Home 896-5762 W.S.IV

ADDRESS 1650 Glenhaven Dr. Huntsville 28078

LOCATION Brawley Sch. Rd TL Stutts Rd TL Island Stream Dr. 1/8-1/4 mile on left

SUBDIVISION Norman Woods BLOCK / SECTION ____ LOT 25 LOT AREA 2.0 per 44² + SITE CLASS. B per 1956 DESIGN FLOW 360 gpd L.T.A.R. .3

Septic Tank: 1000 Gallons; STB 794 Date 6/29/95

Pump Tank: ____ Gallons; PT ____ Date ____

Pump Make: ____ Model ____ Serial No. ____

Nitrification Field: No Fields 1 Square Feet ____ Linear Feet 200

No Lines 3 Trench Width 24" Max Trench Bottom Depth 30" Gravel Depth N/A

☑ New System ☐ Repair System Type: I, II, III, IV, V, VI

System Description: gravity EPPBPS

Repair System Description: same as EPPBPS

Maintenance Agreement Required: ☐ Yes ☑ No

☑ House/Mod. Home No. Bedrooms 3

☐ Mobile Home No. Bathrooms 2.5

☐ Business No. Employees ____

☐ Other ____

☐ Slab ☑ Crawl Space ☐ Basement w/plumbing ☐ Basement wo/plumbing


Water Supply: ☑ Individual ☐ Community ☐ Public

Comments: laterals to follow contour


Comments:

1"=50'

INITIAL SITE SKETCH

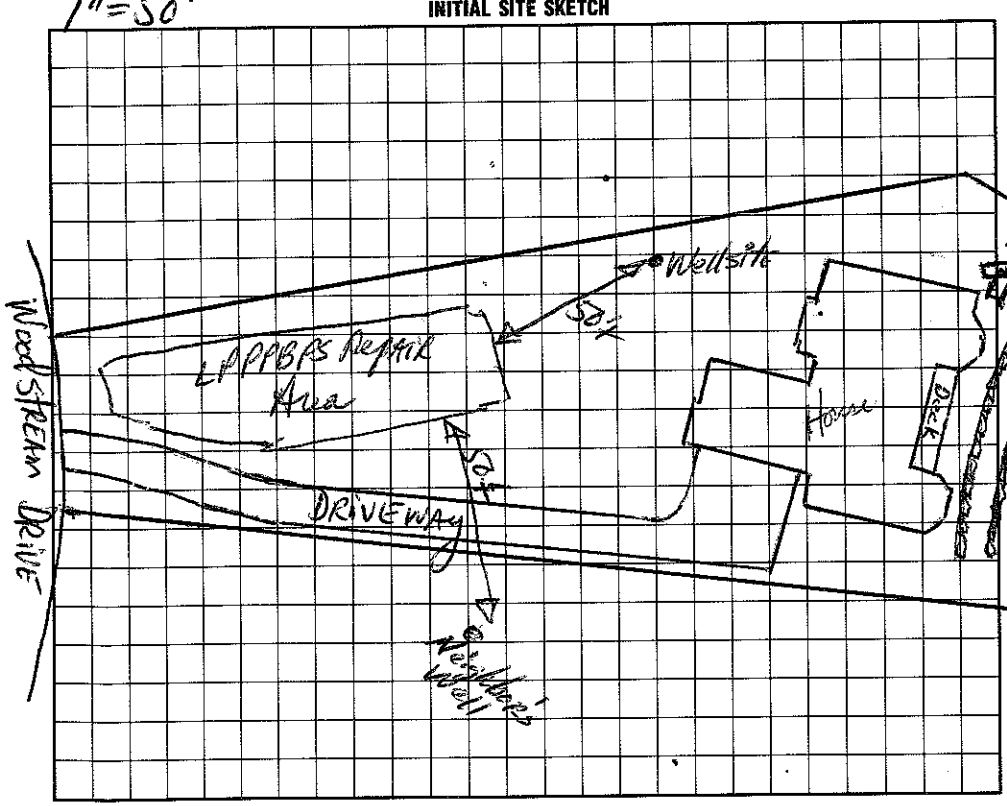

AS BUILT SKETCH

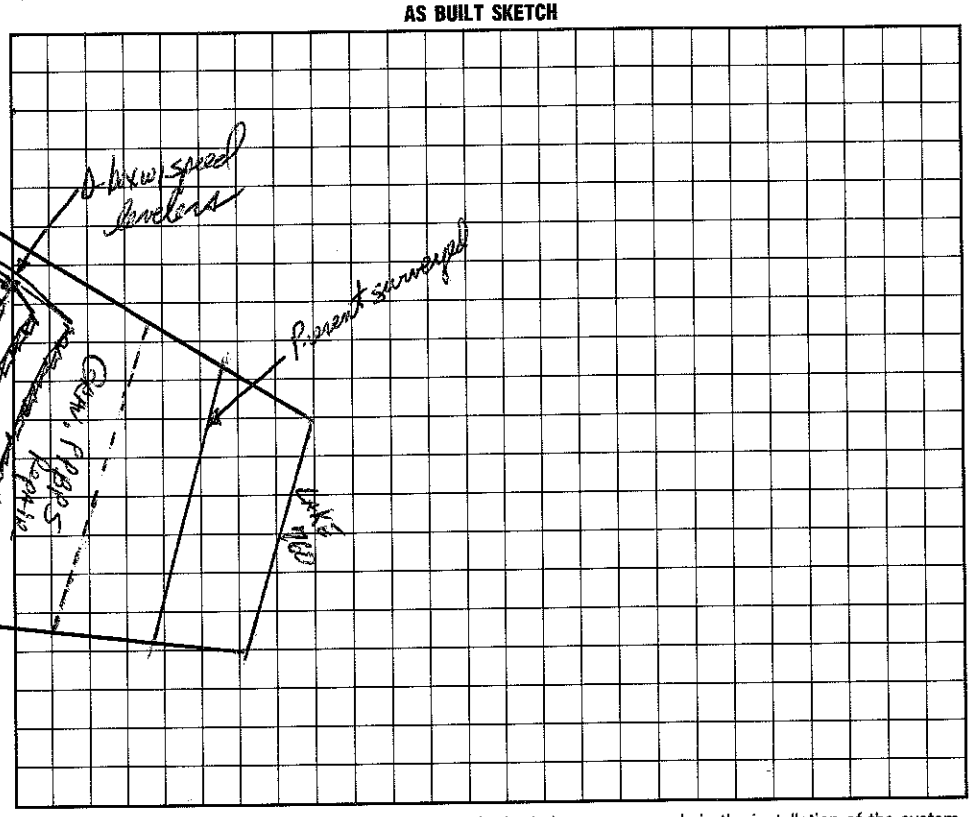

I understand that this permit can be suspended or revoked if any false information is supplied toward securing the permit/any unauthorized changes are made to the site/any unauthorized changes are made in the installation of the system. Improvement Permit is valid for 60 months from date of issuance.

Signed: [signature] (by Hoa)

Improvement Permit by: [signature] RS date 3/27/95

Existing System Inspection by: ____ date ____

Installed by: F & E Envir

Certificate of Completion by: Wesley Sparks RS. date 9/28/95

Operation Permit by: ____ date ____

HEALTH DEPT. COPY: WHITE INSPECTION COPY (FINAL): GREEN OWNER COPY (FINAL): YELLOW INSPECTION COPY (INITIAL): PINK OWNER COPY (INITIAL): GOLD