3 34

IREDELL COUNTY HEALTH DEPARTMENT

STATESVILLE 704-878-5305 MOORESVILLE 704-664-5281

IMPROVEMENT PERMIT / AUTHORIZATION TO CONSTRUCT / OPERATION PERMIT / EXISTING SYSTEM INSPECTION

PERMIT# 143852 PIN# 4636722375.000 4636722377

OWNER OR APPLICANT John+Sidney Thomasson DATE 7/31/07

ADDRESS 195 Woodstream Dr. Mooresville, NC 28117 PHONE: Business 704-342-3990 Home 980-297-6707

LOCATION Brawley School Rd TL Stutts Rd. TL Woodstream, 195 Woodstream Dr.

SUBDIVISION Norman Woods BLOCK / SECTION LOT 32 LOT AREA ≈1.69 SITE CLASS. PS DESIGN FLOW 360 L.T.A.R. .03

Septic Tank: 1000 Gallons: STB 312 Date 12-13-07

Pump Tank: 1000 Gallons: PT 327 Date 12-21-07

Pump Make: MYERS Model ME-50S-21 Serial No. 11106

Nitrification Field: No Fields 1 Square Feet AS 540400 Linear Feet 200'

No Lines 4 Trench Width 24" Max Trench Bottom Depth 36" Gravel Depth N/A

☑ New System ☐ Repair ☐ Expansion System Type: I II III (IV) V VI

System Description: Pump LP PPBPS

Repair System Description: Exempt (Pre-Jan 1, 1983)

Maintenance Agreement Required: ☑ Yes ☐ No

☑ House/Mod. Home ☐ Mobile Home ☐ Business ☐ Other

No. Bedrooms 3 No. Persons ___ No. Employees ___

Water Supply: ☑ Individual ☐ Public ☐ Community

☐ Gravity ☑ Pressure ☐ Slab ☑ Crawl Space ☐ Basement w/plumbing ☐ Basement wo/plumbing

Comments:/Conditions: * Existing Driveway on right side needs to be removed and Front Septic area needs to be leveled by evening out higher elevations for septic contour as drawn

* Exis Well must be properly abandoned b/f AC can be issued


Comments:/Conditions: Well abandoned 8/1/07

3/16 Info Drilled


11/25/08 Checked tanks & lines

1" = 30'

INITIAL SITE SKETCH

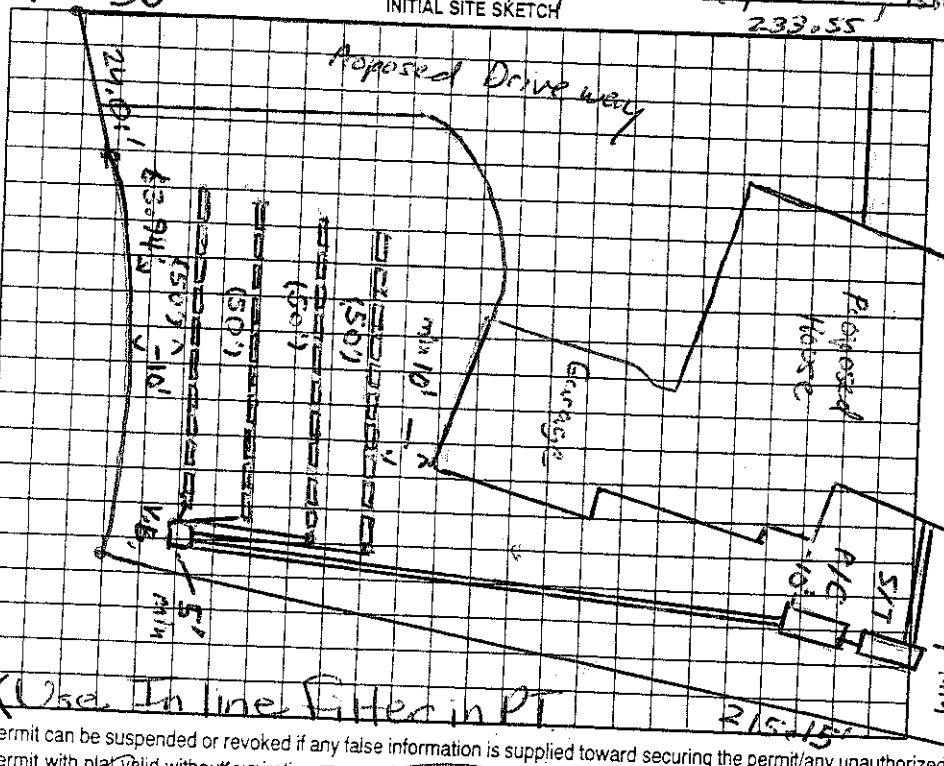

AS BUILT SKETCH

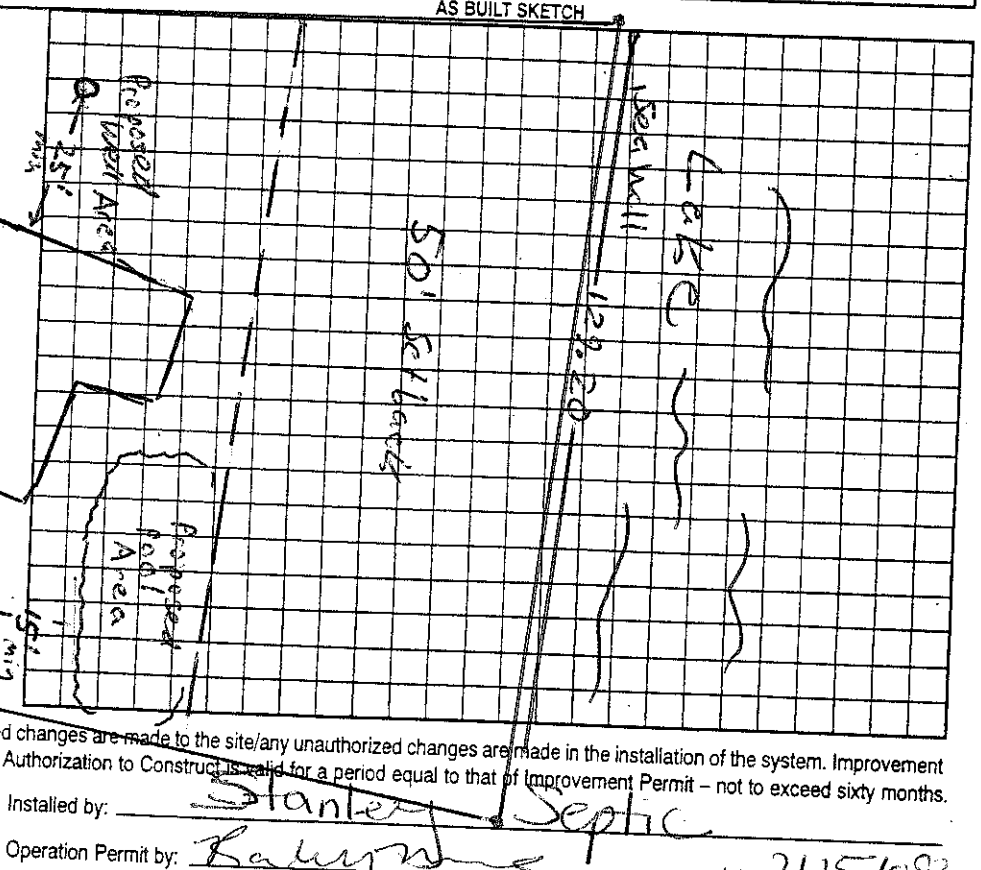

Permit can be suspended or revoked if any false information is supplied toward securing the permit/any unauthorized changes are made to the site/any unauthorized changes are made in the installation of the system. Improvement Permit with plat valid without expiration ☐ Improvement Permit with site plan valid for sixty months ☑ Authorization to Construct is valid for a period equal to that of Improvement Permit – not to exceed sixty months.

Signed: [signature] date 8/2/07

Improvement Permit by: Anthony Cokesh date 7/31/07

Authorization to Construct by: Anthony Cokesh date 8/2/07

Installed by: Stanley Septic

Operation Permit by: [signature] date 2/25/08

Existing System Inspection by: ___ date ___

HEALTH DEPT. COPY: WHITE OWNER COPY (FINAL): YELLOW OWNER COPY (INITIAL): PINK