IREDELL COUNTY HEALTH DEPARTMENT

Statesville Office (704) 878-5305 Mooresville Office (704) 660-3625 PERMIT # 148389

IMPROVEMENT PERMIT / AUTHORIZATION TO CONSTRUCT / OPERATION PERMIT / EXISTING SYSTEM

PIN # 4636-72-2447

APPLICANT: CHARLES & BARBARA DITTRICH APPLICANT ADDRESS: 204 WOODDUCK LOOP

SITE ADDRESS: BSR, STUTTS, WOODSTREAM, ON L PHONE: 704-217-6040 ALT. PHONE: 516-728-2312

✓ SITE DIRECTIONS: 391 WOODSTREAM CR. - Mooresville

✓ SUBDIVISION: NORMAN WOODS SECTION: — LOT # 31 LOT AREA: .154AC DESIGN FLOW: 480 L.T.A.R.: .3

Septic Tank	1000	(gal)	STB	794	Date	5-25-15	☒ New System	☐ Repair	☐ Expansion	System Type: I II ☒ III IV V VI	
Pump Tank	1000	(gal)	PT	27	Date	5-5-15	System Description:	PM - PANEL BLOCK			
Pump Make	GOULDS	Model	WE05	12HHU	Serial #		Repair System Description:	SAME			
# Nitrification Fields	1	# Lines	10	27'	Linear Ft:	270'	Maintenance Agreement Required:	☐ YES	☒ NO		
Trench Width	24"	Max. Trench Bottom Depth	*28"*		Gravel Depth	—		☐ GRAVITY	☒ PRESSURE		

☒ Residence ☐ Business ☐ Other ☒ Slab ☒ Basement w/ plumbing

No. Bedrooms 4 No. Persons — No. Employees — ☒ Crawl Space


Water Supply: ☒ Private ☐ Public ☐ Community

☐ Basement w/o plumbing


Comments / Conditions: ① PLUMBING MUST BE STUBBED OUT WHERE SHOWN ② 10' OF 4" PIPE MUST PRECEDE SEPTIC TANK ③ LOT IS VERY TIGHT, RECOMEND MEETING ON SITE WITH HEALTH DEPT BEFORE INSTALLATION.

CHECKED LINES & TANKS / HOUSE MOVED FORWARD SET 2' PM APPROVED JUL 07 2015

INITIAL SITE SKETCH

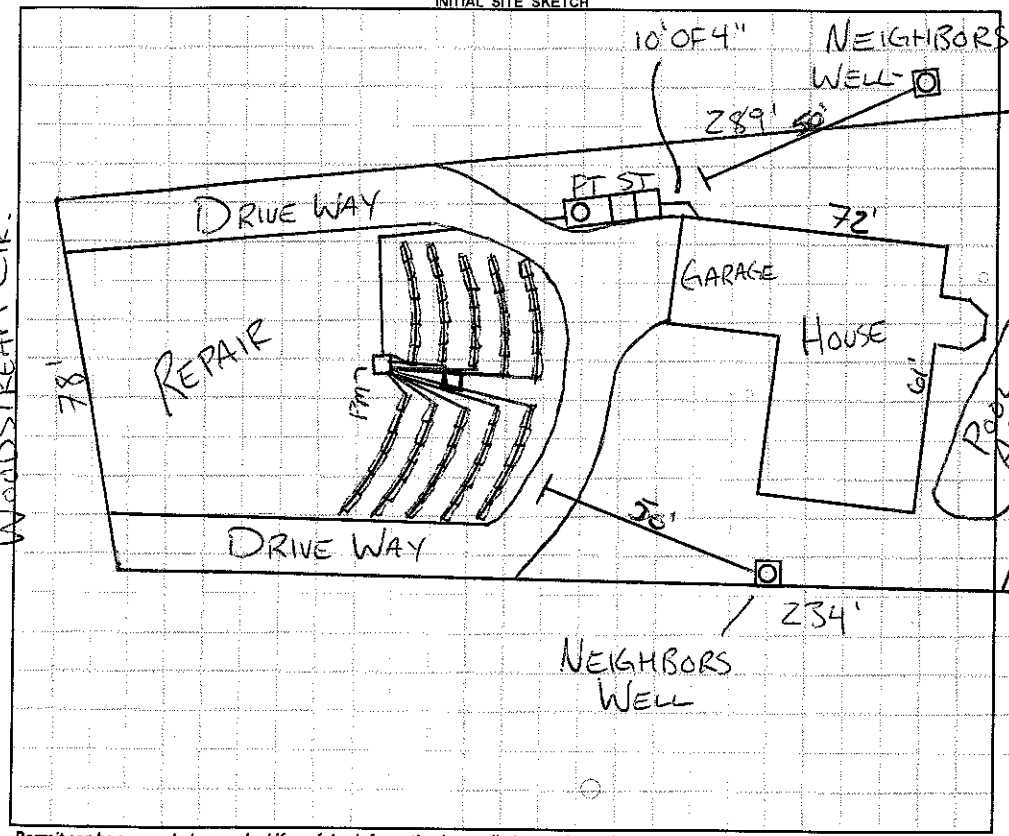

AS BUILT SKETCH

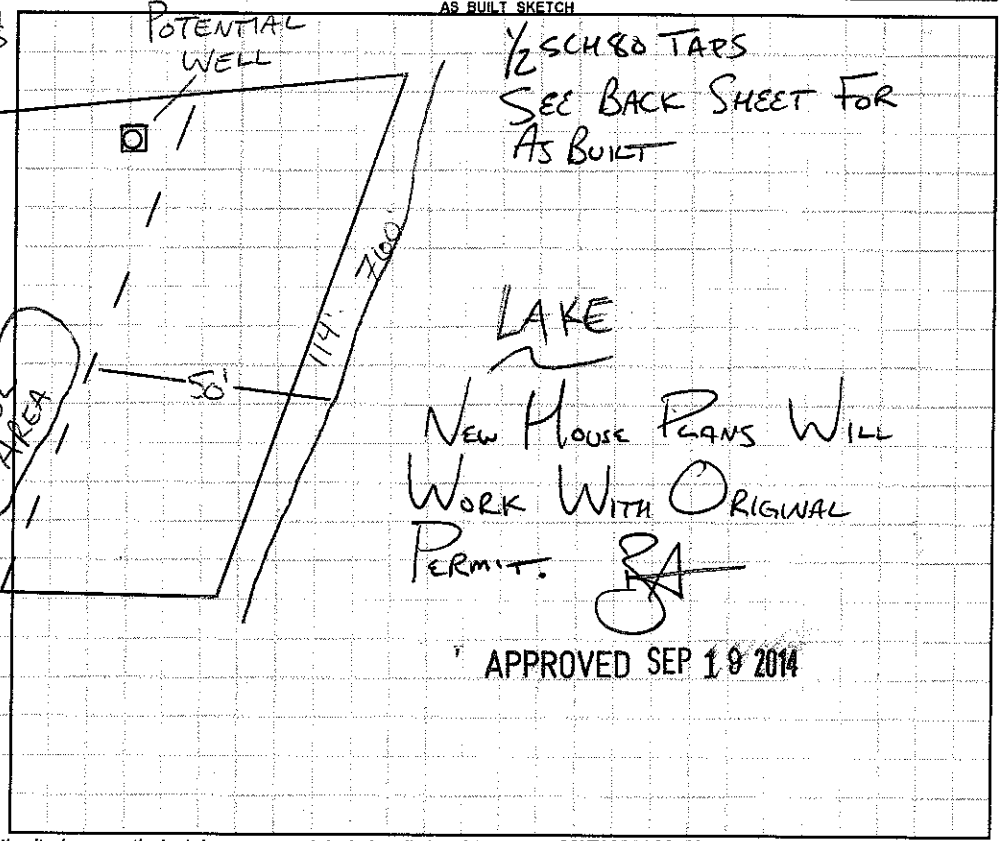

Permit can be suspended or revoked if any false information is supplied toward securing the permit / any unauthorized changes are made to the site / any unauthorized changes are made in the installation of the system. **CONTACT A LOCATOR SERVICE PRIOR TO ANY EXCAVATION**

☐ **IMPROVEMENT PERMIT** *with plat valid without expiration.* ☒ **IMPROVEMENT PERMIT** *with site plan valid for 60 mos.* ☒ **AUTHORIZATION TO CONSTRUCT** *valid for period equal to IMPROVEMENT PERMIT--not to exceed 60 mo.*

Owner / Applicant Signature: _____ Date: 10-31-13 Installed by: KEVIN HALLMAN

IMPROVEMENT PERMIT by: _____ Date: 11-25-13 OPERATION PERMIT by: _____ RS Date: 9/16/15

AUTHORIZATION TO CONSTRUCT by: _____ 11-25-13 Inspected by: _____ Date: _____

Health De

nditional Approval) - PINK