IREDELL COUNTY HEALTH DEPARTMENT

Statesville Office (704) 878-5305 Mooresville Office (704) 660-3625 PERMIT # 179991

IMPROVEMENT PERMIT / AUTHORIZATION TO CONSTRUCT / OPERATION PERMIT / EXISTING SYSTEM

PIN # 4636-75-2708

APPLICANT: JSE BUILDERS INC. APPLICANT ADDRESS: 5171 SHOREVIEW DR. CONCORD

SITE ADDRESS: 189 PINTAIL RUN LN. PHONE: 704-791-1300 ALT. PHONE:

SITE DIRECTIONS: RSR, TL CANVASBACK, TR OLD SQUAW, TL BILLY JOE, TR PINTAIL, ON L

SUBDIVISION: THE HAMMOCKS @ MALLARD HEAD SECTION: LOT # 3 LOT AREA: 1.13 AC DESIGN FLOW: 360 L.T.A.R.: .2(.1)R

Septic Tank 1000 (gal) STB 525 Date 1-30-14
Pump Tank 1000 (gal) PT 302 Date 2-7-14
Pump Make Geller Model N152 Serial #
Nitrification Fields 1 # Lines 5 Linear Ft: 450'
Trench Width 36" Max. Trench Bottom Depth * 12" * Gravel Depth

☒ New System ☐ Repair ☐ Expansion System Type: I II (III)B IV V VI
System Description: AT GRADE 25% PM
Repair System Description: DRIP - TS#
Maintenance Agreement Required: ☐ YES ☒ NO ☐ GRAVITY ☒ PRESSURE


☒ Residence ☐ Business ☐ Other ☐ Slab ☒ Crawl Space ☐ Basement w/plumbing
No. Bedrooms 3 No. Persons No. Employees
☐ Basement w/o plumbing

Water Supply: ☒ Private ☐ Public ☐ Community

Comments / Conditions:

6" OF COVER MUST BE PUT OVER SYSTEM
4/2/14
2 PRESSURE set tanks & lines installed essentially as drawn.

INITIAL SITE SKETCH

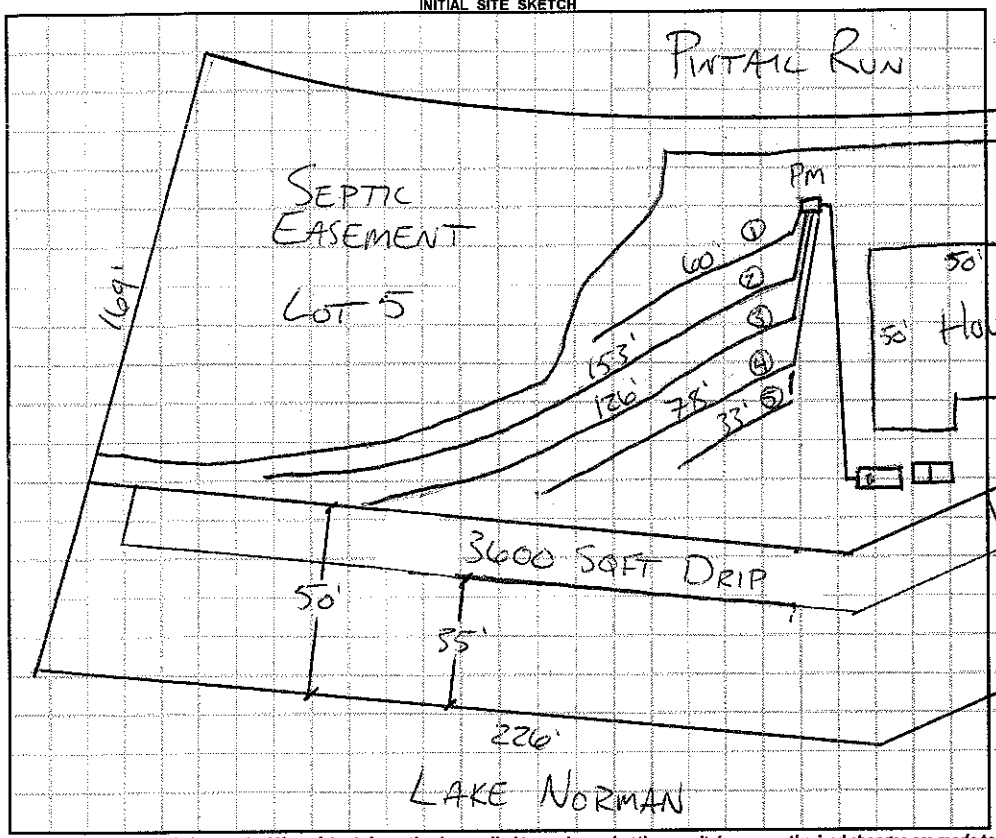

AS BUILT SKETCH

TAP SIZES
① 1½" SCH 80
② ¾" SCH 40
③ ¾" SCH 80
④ & ⑤ ¾" SCH 80
} Checked Taps

HOOK LINES 4 & 5 TOGETHER
4/28/14 Checked Elect & Alarm

Permit can be suspended or revoked if any false information is supplied toward securing the permit / any unauthorized changes are made to the site / any unauthorized changes are made in the installation of the system. **CONTACT A LOCATOR SERVICE PRIOR TO ANY EXCAVATION**

☐ **IMPROVEMENT PERMIT** *with plat valid without expiration.* ☐ **IMPROVEMENT PERMIT** *with site plan valid for 60 mos.* ☒ **AUTHORIZATION TO CONSTRUCT** *valid for period equal to IMPROVEMENT PERMIT--not to exceed 60 mo.*

Owner / Applicant Signature: Date: 2/7/14 Installed by: Rowan Septic

IMPROVEMENT PERMIT by: Date: 2-7-14 OPERATION PERMIT by: Date: 4/28/14

AUTHORIZATION TO CONSTRUCT by: Date: 2-7-14 Existing System Inspected by: Date:

Health Dept. Copy - WHITE Applicant (Final Approval) - YELLOW Applicant (Conditional Approval) - PINK