IREDELL COUNTY HEALTH DEPARTMENT

STATESVILLE 704-878-5305 MOORESVILLE 704-664-5281

IMPROVEMENT PERMIT / AUTHORIZATION TO CONSTRUCT / OPERATION PERMIT / EXISTING SYSTEM INSPECTION

PERMIT# 124408 PIN# 4636-76-3226.9 4636-75-6567 DATE 12/10/04

OWNER OR CONTRACTOR Burke Builders of NC LLC PHONE: Business 704 361 0047 Home 704-662-0047

ADDRESS PO Box 3481 Mooresville NC 28115

LOCATION BSR, TL Canvasback, TR Old Squaw, TL Billy Joe, TR Pintail Run, TL Spring Run, on Rt.

SUBDIVISION Hammocks BLOCK / SECTION LOT 9 LOT AREA 1.39AC SITE CLASS PS DESIGN FLOW 360 L.T.A.R. 0.3

Septic Tank: 1000 Gallons; STB 294 Date 3/13/04
Pump Tank: 1000 Gallons; PT 29 Date
Pump Make: Gould Model EP0911A Serial No.
Nitrification Field: No Fields 1 Square Feet 900 Linear Feet 300'
No Lines 2 @ 150' Trench Width 36" Max Trench Bottom Depth 18" Gravel Depth —

☒ New System ☐ Repair System Type: I, II, (III), IV, V, VI
System Description: PM 25% Reduction
Repair System Description: LP 25% Reduction
Maintenance Agreement Required: ☐ Yes ☒ No

☒ House/Mod. Home No. Bedrooms 3
☐ Mobile Home No. Bathrooms
☐ Business No. Employees
☐ Other


☐ Slab ☒ Crawl Space ☐ Basement w/plumbing ☐ Basement wo/plumbing

Water Supply: ☒ Individual ☐ Public ☐ Community


Comments/Conditions:
1"=60'

Comments/Conditions:
Well Easement okied by DWQ (attached)

INITIAL SITE SKETCH

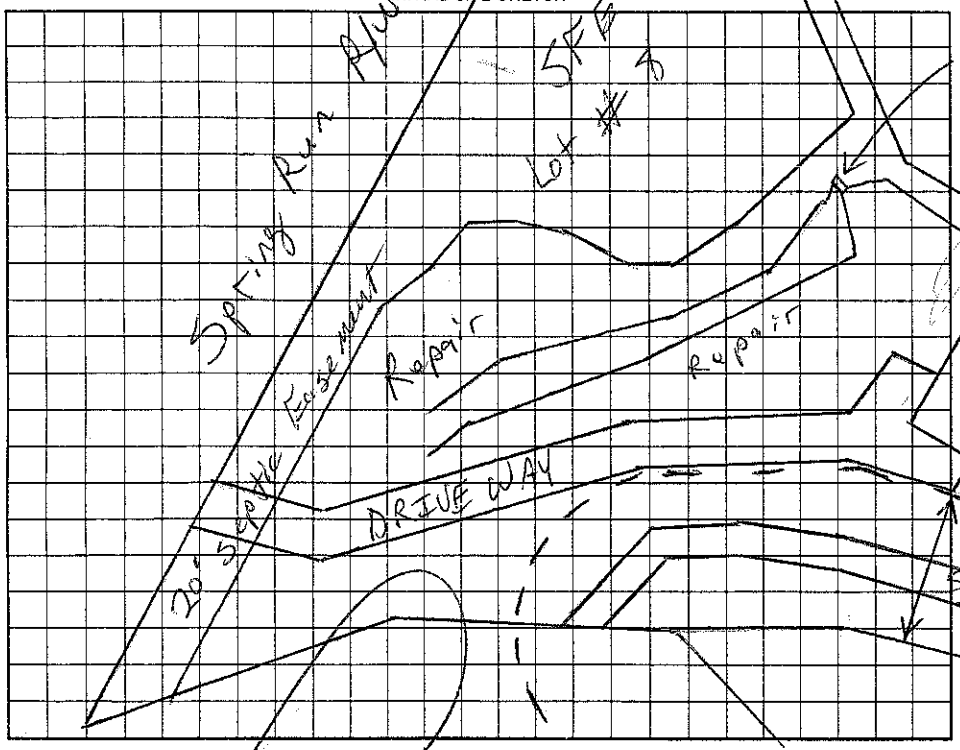

AS BUILT SKETCH

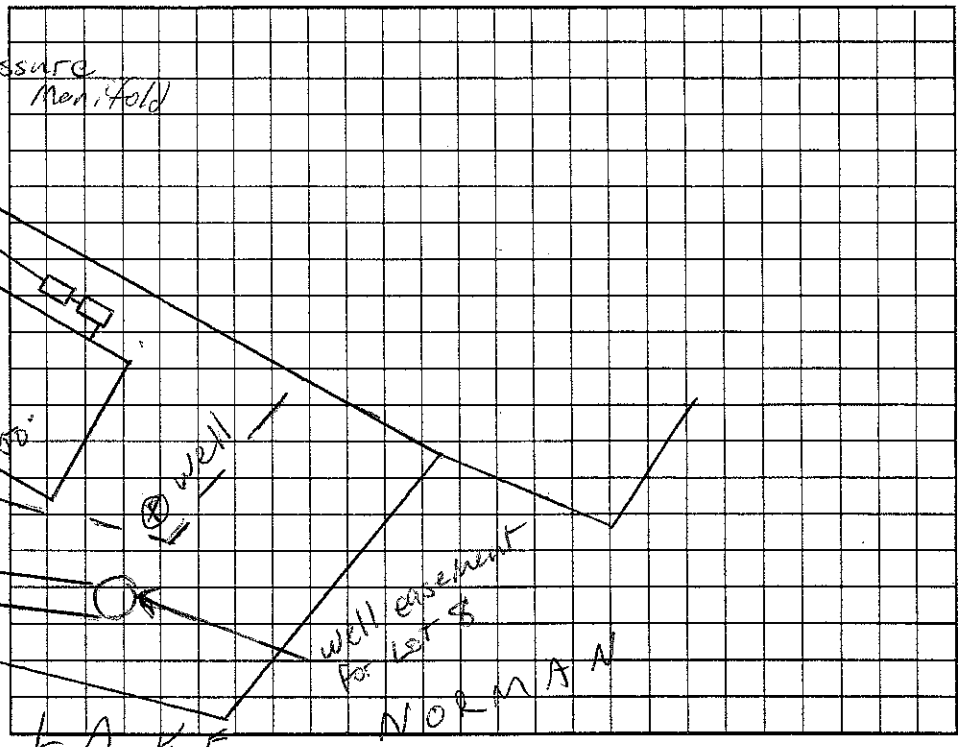

Permit can be suspended or revoked if any false information is supplied toward securing the permit/any unauthorized changes are made to the site/any unauthorized changes are made in the installation of the system. Improvement Permit with plat valid without expiration. Improvement Permit with site plan valid for sixty months. Authorization to Construct is valid for a period equal to that of Improvement Permit – not to exceed sixty months.

Signed: date 12/10/04 Installed by: Bob McCarver

Improvement Permit by: RS date 12/10/04 Operation Permit by: RS date 9/2/05

Authorization to Construct by: RS date 8/22/05 Existing System Inspection by: date

HEALTH DEPT. COPY: WHITE OWNER COPY (FINAL): YELLOW OWNER COPY (INITIAL): PINK