IREDELL COUNTY HEALTH DEPARTMENT

(SEPTIC TANK) IMPROVEMENTS PERMIT AND CERTIFICATE OF COMPLETION
(Ground Absorption Sewage Disposal System -- G. S. Chapter 130-Article 13C)

OWNER OR CONTRACTOR Mady Construction DATE Aug 28, '87 PERMIT NO. _____

PHONE: Business _____ Home _____

LOCATION 1100 N 1179 (Connorback) TR Spring Run Drive 1/4-1/2 mile on Rt. S. R. No. _____

SUBDIVISION NAME Spring Run - Mallard Head LOT NO. 127 SECTION OR BLOCK NO. _____

House (✓) Mobile Home ( ) Business ( ) Other _____

No. Bedrooms 3 No. Bathrooms 2

Garbage Disposal Unit Yes ( ) No (✓)
Auto. Dishwasher Yes (✓) No ( )
Auto. Wash. Machine Yes (✓) No ( )
Site Suitable Yes ( ) No ( )


Lot Area 50'X120' easement for drainfield behind Lot 125

Character & Porosity of Soil Easement behind Lot 125 clay
Percolation Rate 2, 3
Topography 2-6%
Depth to Water Table 3'+
Rock or other impervious formations some small scattered rock

_____ Basement with Plumbing _____ Basement without Plumbing _____ No Basement

1000 gal pump tank
Size of Tank 1000 Gals.

Nitrification Field:
No. of Lines 5-6
Sq. Ft. _____ Linear Ft. 300'@ 16'
Depth of Stone in Lines 7"-8" pipe/s
Water Supply: Individual ( ) pressure dosed
Public (✓)

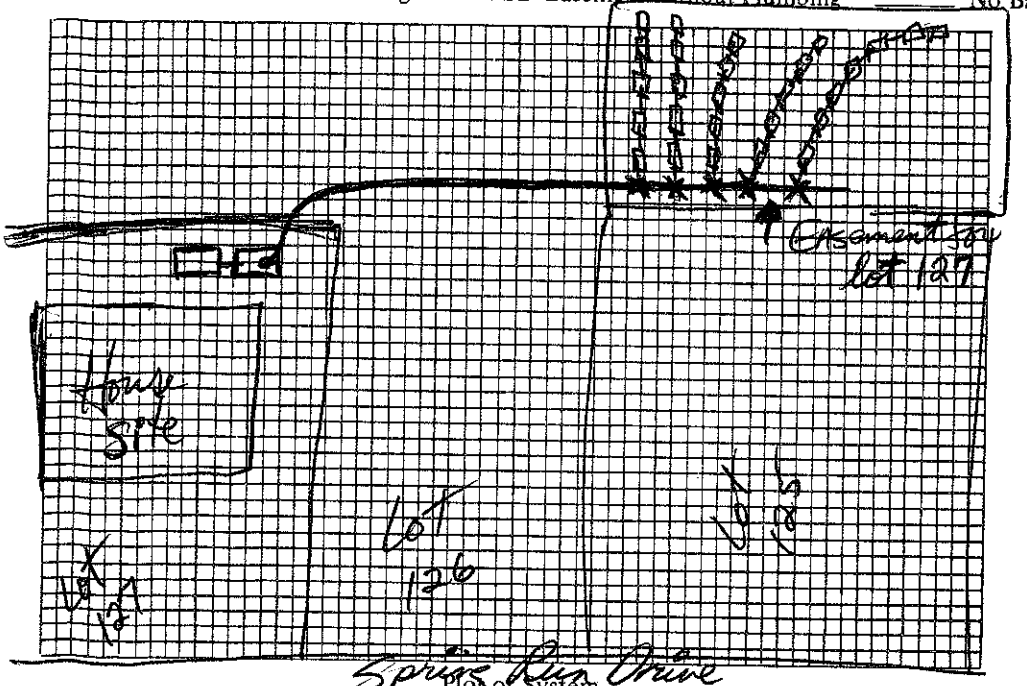

Plan of System

Installed by _____

I understand and agree to install septic tank system as specified on this Improvements Permit.

Signed: Paul Higgs

IMPROVEMENTS PERMIT BY David R. Henson, R.S.

COMMENTS: Can adjust tank locations as needed on lot as long as minimum distances required from all constraints are maintained. (Tanks to be at least 15' from foundation if there is a basement with plumbing with tanks above basement level). Follow contour with pipe/s

CERTIFICATE OF COMPLETION BY _____ DATE _____

EXISTING SYSTEM CHECKED BY: _____ DATE _____

CONSTRUCTION MUST COMPLY WITH ALL OTHER APPLICABLE STATE AND LOCAL REGULATIONS.

Permit is VOID if any unauthorized changes are made in installation of system and/or if any false information is supplied in making Improvements Permit.

Health Dept. Copy: White Inspection Dept. Copy: Yellow Sanitarian's Copy: Pink Owner's Copy: Gold