IREDELL COUNTY HEALTH DEPARTMENT

Statesville Office (704) 878-5305 Mooresville Office (704) 660-3625 PERMIT # 213463

IMPROVEMENT PERMIT / AUTHORIZATION TO CONSTRUCT / OPERATION PERMIT / EXISTING SYSTEM

PIN # 4636 75 9626

APPLICANT: SIDNEY LEE CRUSE APPLICANT ADDRESS:

SITE ADDRESS: 141 SPRING RUN DR MOORESVILLE NC PHONE: 704 907 2253 ALT. PHONE:

SITE DIRECTIONS: BRAWLEY SCHOOL - TL CANVASBACK - TR OLD SQUAW - TL PINTAIL - TL SPRING RUN - ON LT

SUBDIVISION: MALLARD HEAD SECTION: 1 LOT # 128 LOT AREA: .46AC DESIGN FLOW: 3 L.T.A.R.: EXISTING


Septic Tank	(gal)	STB	Date	☑ New System	☐ Repair	☐ Expansion	System Type: I II (III) IV V VI	☑ Residence	No. Bedrooms	3	Water Supply
Pump Tank	(gal)	PT	Date	System Description:	GRAVITY	PPBPS		☐ Business	No. Persons	3	☐ Private
Pump Make	Model	EXISTING	Serial #	Repair System Description:		SAME		☐ Other	No. Employees		☐ Public
# Nitrification Fields	# Lines		Linear Ft:	Maintenance Agreement Required:	☐ YES	☑ NO		☐ Slab	☑ Crawl Space		☑ Community
Trench Width	Max. Trench Bottom Depth		Gravel Depth		☑ GRAVITY	☐ PRESSURE		☐ Basement w/plumbing		☐ Basement w/o plumbing	

Comments / Conditions:

SYSTEM ~~FAILED~~ FUNCTIONING PROPERLY AT TIME OF INSPECTION

INITIAL SITE SKETCH

AS BUILT SKETCH

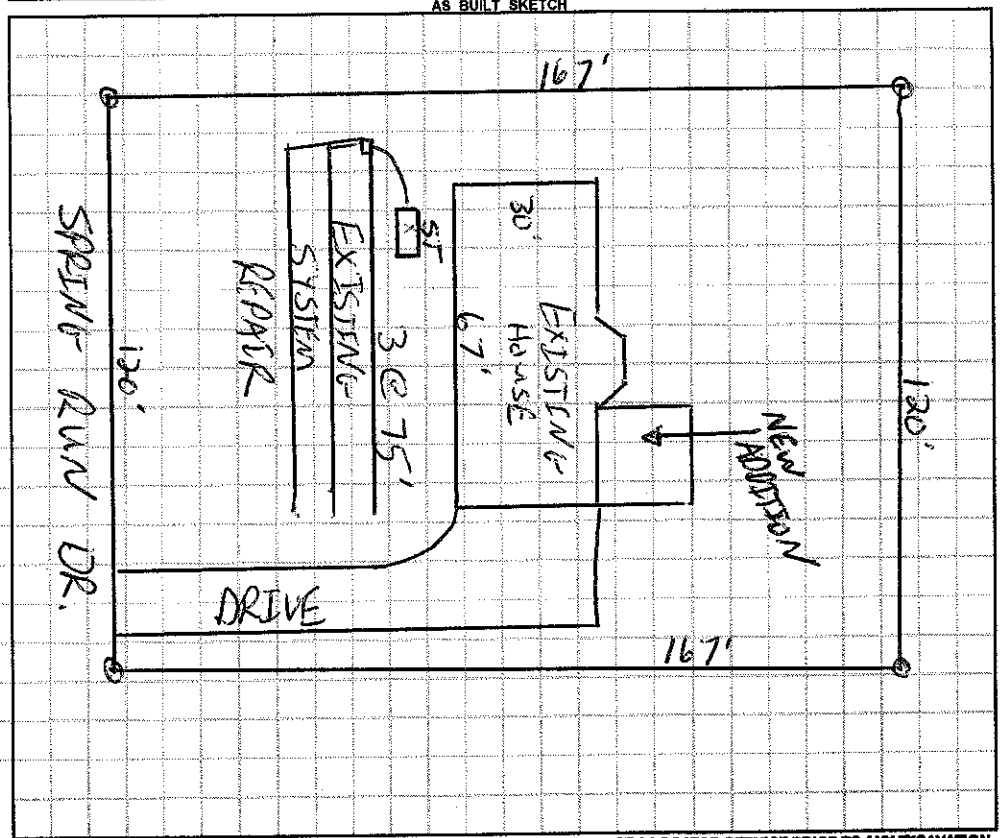

Permit can be suspended or revoked if any false information is supplied toward securing the permit / any unauthorized changes are made to the site / any unauthorized changes are made in the installation of the system. **CONTACT A LOCATOR SERVICE PRIOR TO ANY EXCAVATION**

☐ **IMPROVEMENT PERMIT** *with plat valid without expiration.* ☐ **IMPROVEMENT PERMIT** *with site plan valid for 60 mos.* ☐ **AUTHORIZATION TO CONSTRUCT** *valid for period equal to IMPROVEMENT PERMIT--not to exceed 60 mo.*

Owner / Applicant Signature: [signature] Date: 10-22-15 Installed by:

IMPROVEMENT PERMIT by: Date: OPERATION PERMIT by: Date:

AUTHORIZATION TO CONSTRUCT by: Date: Existing System Inspected by: [signature] Date: 10/20/15

Health Dept. Copy - WHITE Applicant (Final Approval) - YELLOW Applicant (Conditional Approval) - PINK