IREDELL COUNTY HEALTH DEPARTMENT

Statesville Office (704) 878-5305 Mooresville Office (704) 660-3625 PERMIT # 180611

IMPROVEMENT PERMIT / AUTHORIZATION TO CONSTRUCT / OPERATION PERMIT / EXISTING SYSTEM

PIN # 4636759717

APPLICANT: Jenaper Loma Hill LLC APPLICANT ADDRESS: PO Box 5351 Mooresville NC 28117

SITE ADDRESS: Spring Run Dr. PHONE: ALT. PHONE:

SITE DIRECTIONS: Brawley School - TL Canvasback - TR Old Squaw - TL Billy Joe - TR Pintail - TL Springrun - Lot on LT

SUBDIVISION: Mallard Head CC SECTION: 1 LOT # 129 LOT AREA: DESIGN FLOW: 360 L.T.A.R.: .3

Septic Tank	1000	(gal)	STB	10-17	Date	9-24-14	☑ New System	☐ Repair	☐ Expansion	System Type: I II III (IV) V VI	
Pump Tank	1000	(gal)	PT	17	Date	9-24-14	System Description:	LPPPBBS OFFSITE			
Pump Make	Goulds	Model	WE10	2H	Serial #	1HP	Repair System Description:	SAME OFFSITE			
# Nitrification Fields	1	# Lines	3		Linear Ft:	200	Maintenance Agreement Required:	☑ YES	☐ NO		
Trench Width	24"	Max. Trench Bottom Depth	36"		Gravel Depth	N/A		☐ GRAVITY	☐ PRESSURE		

☑ Residence	No. Bedrooms	3	Water Supply	
☐ Business	No. Persons	6	☐ Private	
☐ Other	No. Employees		☐ Public	
☐ Slab	☑ Crawl Space		☑ Community	
☐ Basement w/plumbing			☐ Basement w/o plumbing	

Comments / Conditions: DO NOT ISSUE AC UNTIL EASEMENT IS RECORDED PROPERLY

INITIAL SITE SKETCH

SEE CAROLINA SOIL & SEPTIC CONSULTANTS PLAN.

5/32" Hole

AS BUILT SKETCH

CHECKED LINES

APPROVED AUG 20 2014 RA

CHECKED TANKS

PUMP

SET PM

ELECTRICAL

APPROVED FEB 06 2015 RA

Permit can be suspended or revoked if any false information is supplied toward securing the permit / any unauthorized changes are made to the site / any unauthorized changes are made in the installation of the system. **CONTACT A LOCATOR SERVICE PRIOR TO ANY EXCAVATION**

☐ **IMPROVEMENT PERMIT** *with plat valid without expiration.* ☑ **IMPROVEMENT PERMIT** *with site plan valid for 60 mos.* ☒ **AUTHORIZATION TO CONSTRUCT** *valid for period equal to IMPROVEMENT PERMIT--not to exceed 60 mo.*

Owner / Applicant Signature: Date: 3/14/14 Installed by: CRAIG THOMPSON

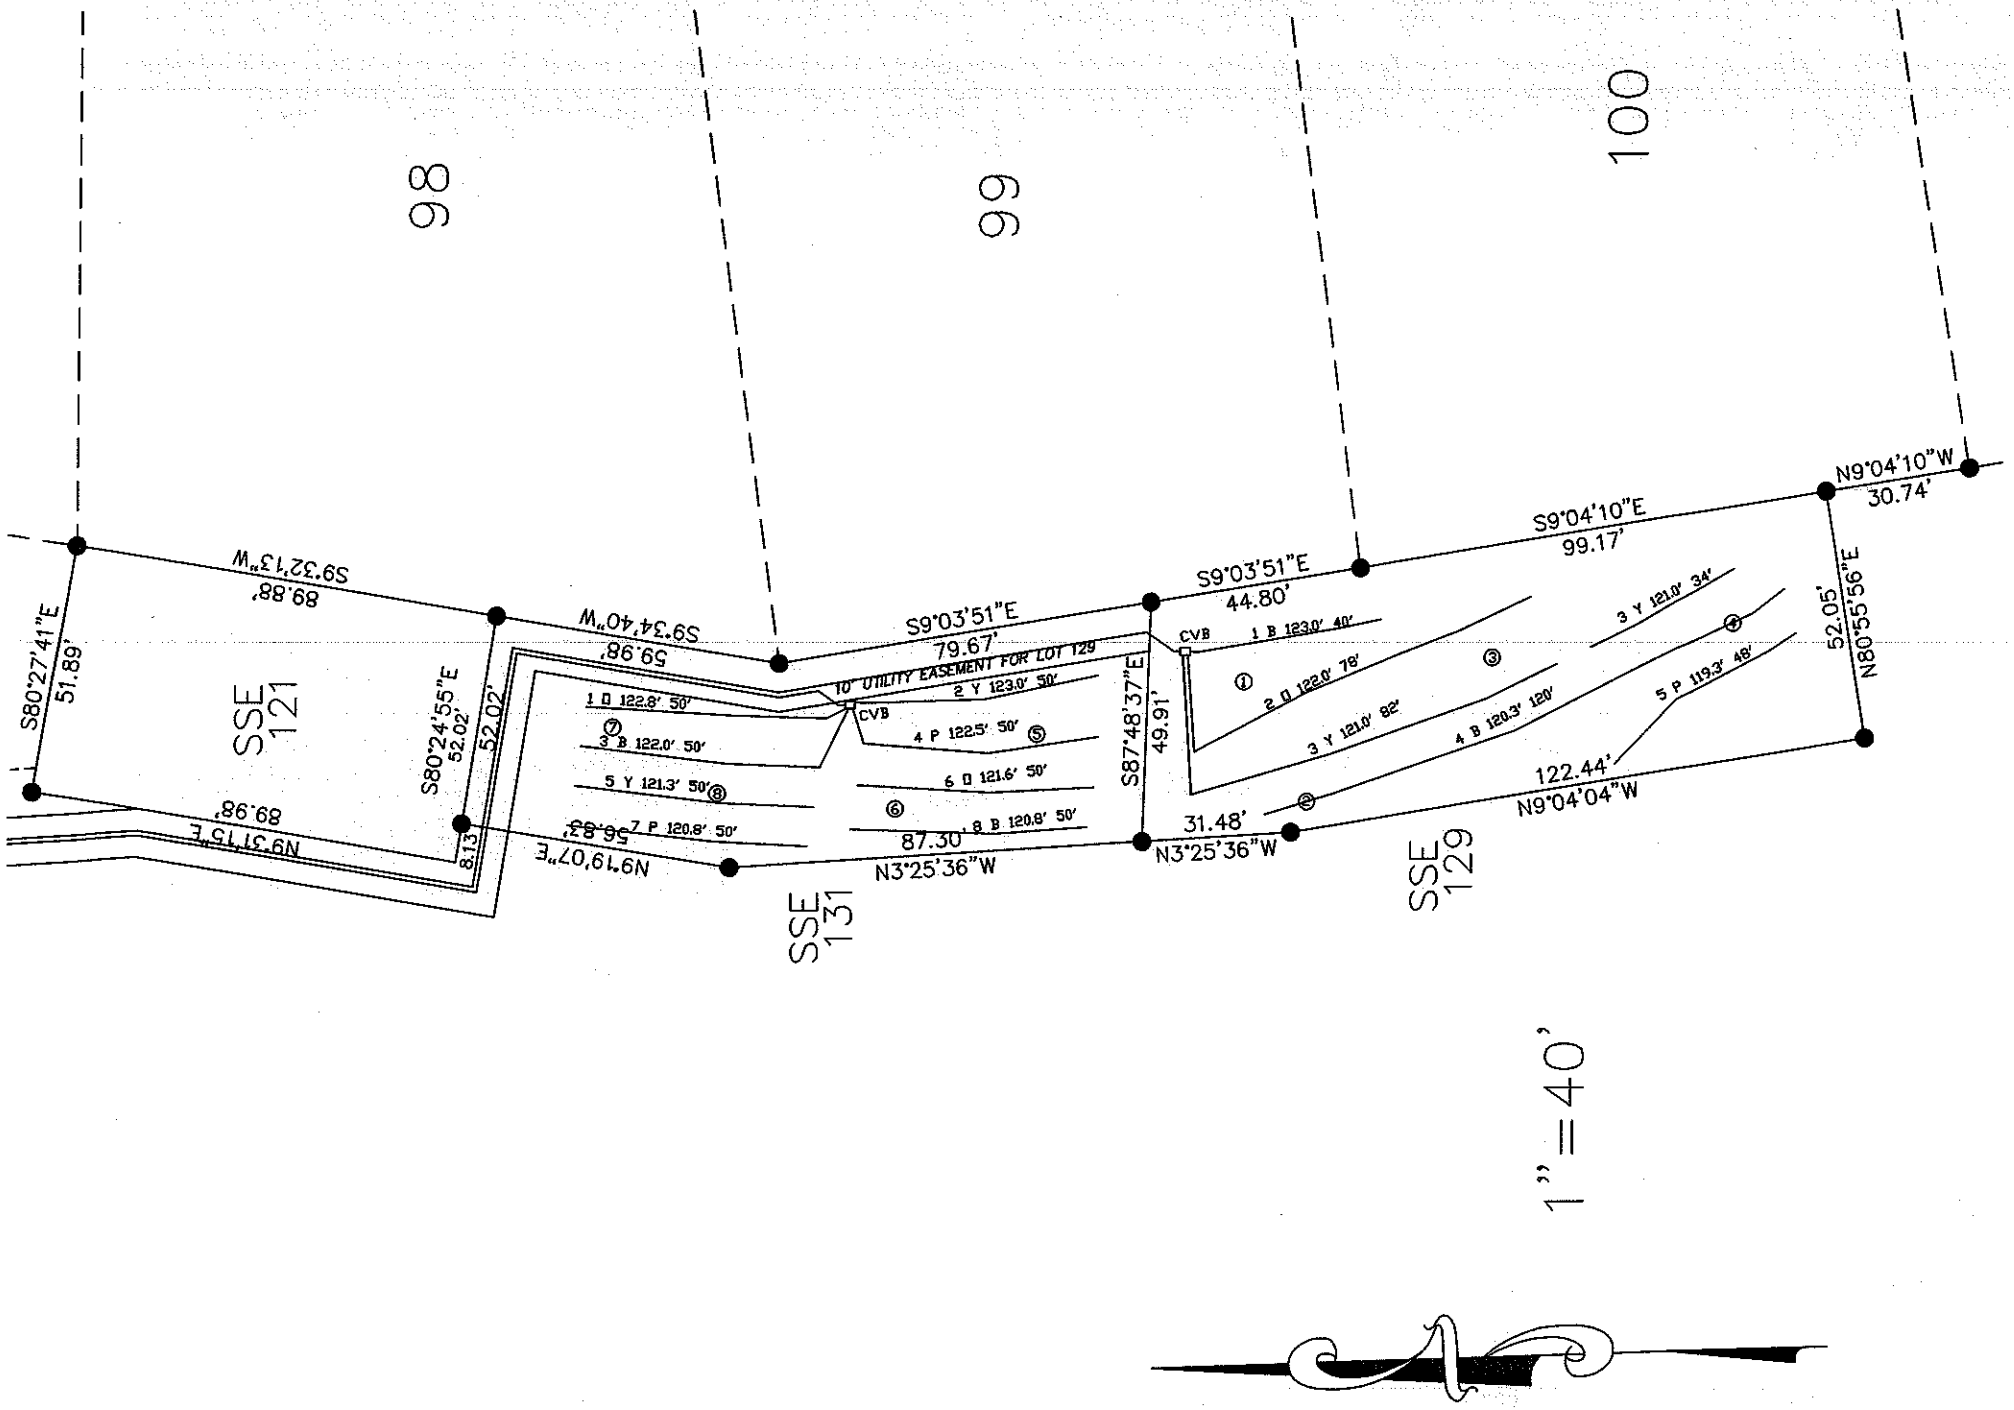
IMPROVEMENT PERMIT by: Date: 8/29/0

AUTHORIZATION TO CONSTRUCT by: Date: APPROVED MAR 14 2014

OPERATION PERMIT by: Date: APPROVED FEB 12 2015

Existing System Inspected by: Date:

Health Dept. Copy - WHITE Applicant (Final Approval) - YELLOW Applicant (Conditional Approval) - PINK


98
99
100
SSE 121
SSE 131
SSE 129
S80°27'41"E
51.89'
S9°32'13"W
89.88'
S9°34'40"W
59.98'
S9°03'51"E
79.67'
S9°03'51"E
44.80'
S9°04'10"E
99.17'
N9°04'10"W
30.74'
S80°24'55"E
52.02'
52.02'
10' UTILITY EASEMENT FOR LOT 129
CVB
CVB
1 B 123.0' 40'
2 Y 123.0' 50'
1 D 122.8' 50'
3 B 122.0' 50'
4 P 122.5' 50'
5 Y 121.3' 50'
6 D 121.6' 50'
7 P 120.8' 50'
8 B 120.8' 50'
S87°48'37"E
49.91'
2 D 122.0' 78'
3 Y 121.0' 82'
3 Y 121.0' 34'
4 B 120.3' 120'
5 P 119.3' 48'
52.05'
N80°55'56"E
N9°31'15"E
89.98'
8.13'
N9°19'07"E
56.83'
87.30'
N3°25'36"W
31.48'
N3°25'36"W
122.44'
N9°04'04"W
1" = 40'