IREDELL COUNTY HEALTH DEPARTMENT

Statesville Office (704) 878-5305 Mooresville Office (704) 660-3625 PERMIT # 209530

IMPROVEMENT PERMIT / AUTHORIZATION TO CONSTRUCT / OPERATION PERMIT / EXISTING SYSTEM

PIN # 4636-75-9717.000

APPLICANT: Award Pools APPLICANT ADDRESS: 168 Pleasant Creek Dr.

SITE ADDRESS: 135 Spring Run Dr. Mooresville NC PHONE: 704-746-9932 ALT. PHONE:

SITE DIRECTIONS: BSR, TR Cantebrak, TR Spring Run

SUBDIVISION: Mallard Head Country Club SECTION: 1 LOT # 129 LOT AREA: .46 ACRE DESIGN FLOW: Ex. L.T.A.R.: Ex

Septic Tank	Ex	(gal)	STB		Date		☐ New System	☐ Repair	☐ Expansion	System Type: I II III IV V VI		☒ Residence	No. Bedrooms	3	Water Supply				
Pump Tank	Ex	(gal)	PT		Date		System Description:	Existing LP-PPBPS				☐ Business	No. Persons	6	☐ Private				
Pump Make	Ex	Model	Ex		Serial #	Ex	Repair System Description:	Existing				☐ Other	No. Employees		☐ Public				
# Nitrification Fields	Ex	# Lines	Ex		Linear Ft:	Ex.	Maintenance Agreement Required:	☒ YES	☐ NO			☐ Slab	☒ Crawl Space		☒ Community				
Trench Width	Ex	Max. Trench Bottom Depth	Ex		Gravel Depth	Ex.		☐ GRAVITY	☒ PRESSURE			☐ Basement w/plumbing			☐ Basement w/o plumbing				


Comments / Conditions: * Maintain 10' From Any Supply Line For Septic From Pool.

This Permit is for Addition of a 15'x30' Pool Area.
Maintenance Contract on File.

INITIAL SITE SKETCH

1"=40'

AS BUILT SKETCH

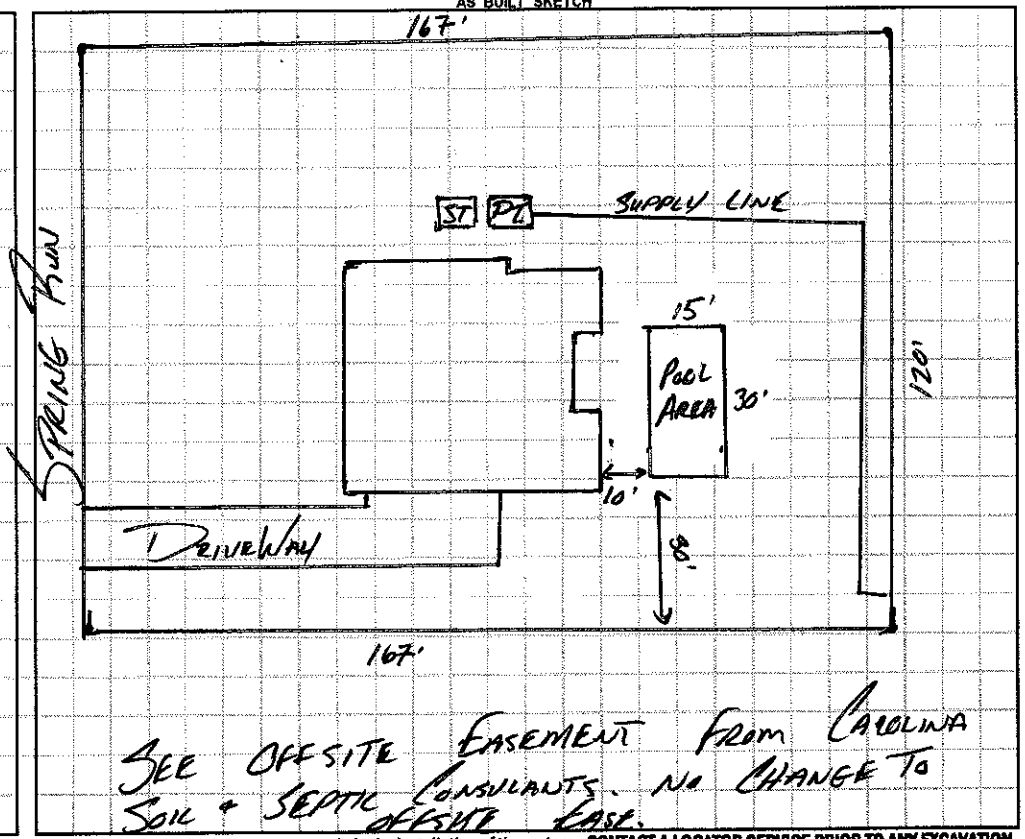

See Offsite Easement From Carolina Soil & Septic Consultants. No Change To Offsite Ease.

Permit can be suspended or revoked if any false information is supplied toward securing the permit / any unauthorized changes are made to the site / any unauthorized changes are made in the installation of the system. **CONTACT A LOCATOR SERVICE PRIOR TO ANY EXCAVATION**


☐ **IMPROVEMENT PERMIT** *with plat valid without expiration.* ☐ **IMPROVEMENT PERMIT** *with site plan valid for 60 mos.* ☐ **AUTHORIZATION TO CONSTRUCT** *valid for period equal to IMPROVEMENT PERMIT--not to exceed 60 mo.*

Owner / Applicant Signature: [signature] Date: 5-19-15 Installed by:

IMPROVEMENT PERMIT by: Date: OPERATION PERMIT by: Date:

AUTHORIZATION TO CONSTRUCT by: Date: Existing System Inspected by: [signature] Date: APPROVED APR 30 2015

Health Dept. Copy - WHITE Applicant (Final Approval) - YELLOW Applicant (Conditional Approval) - PINK

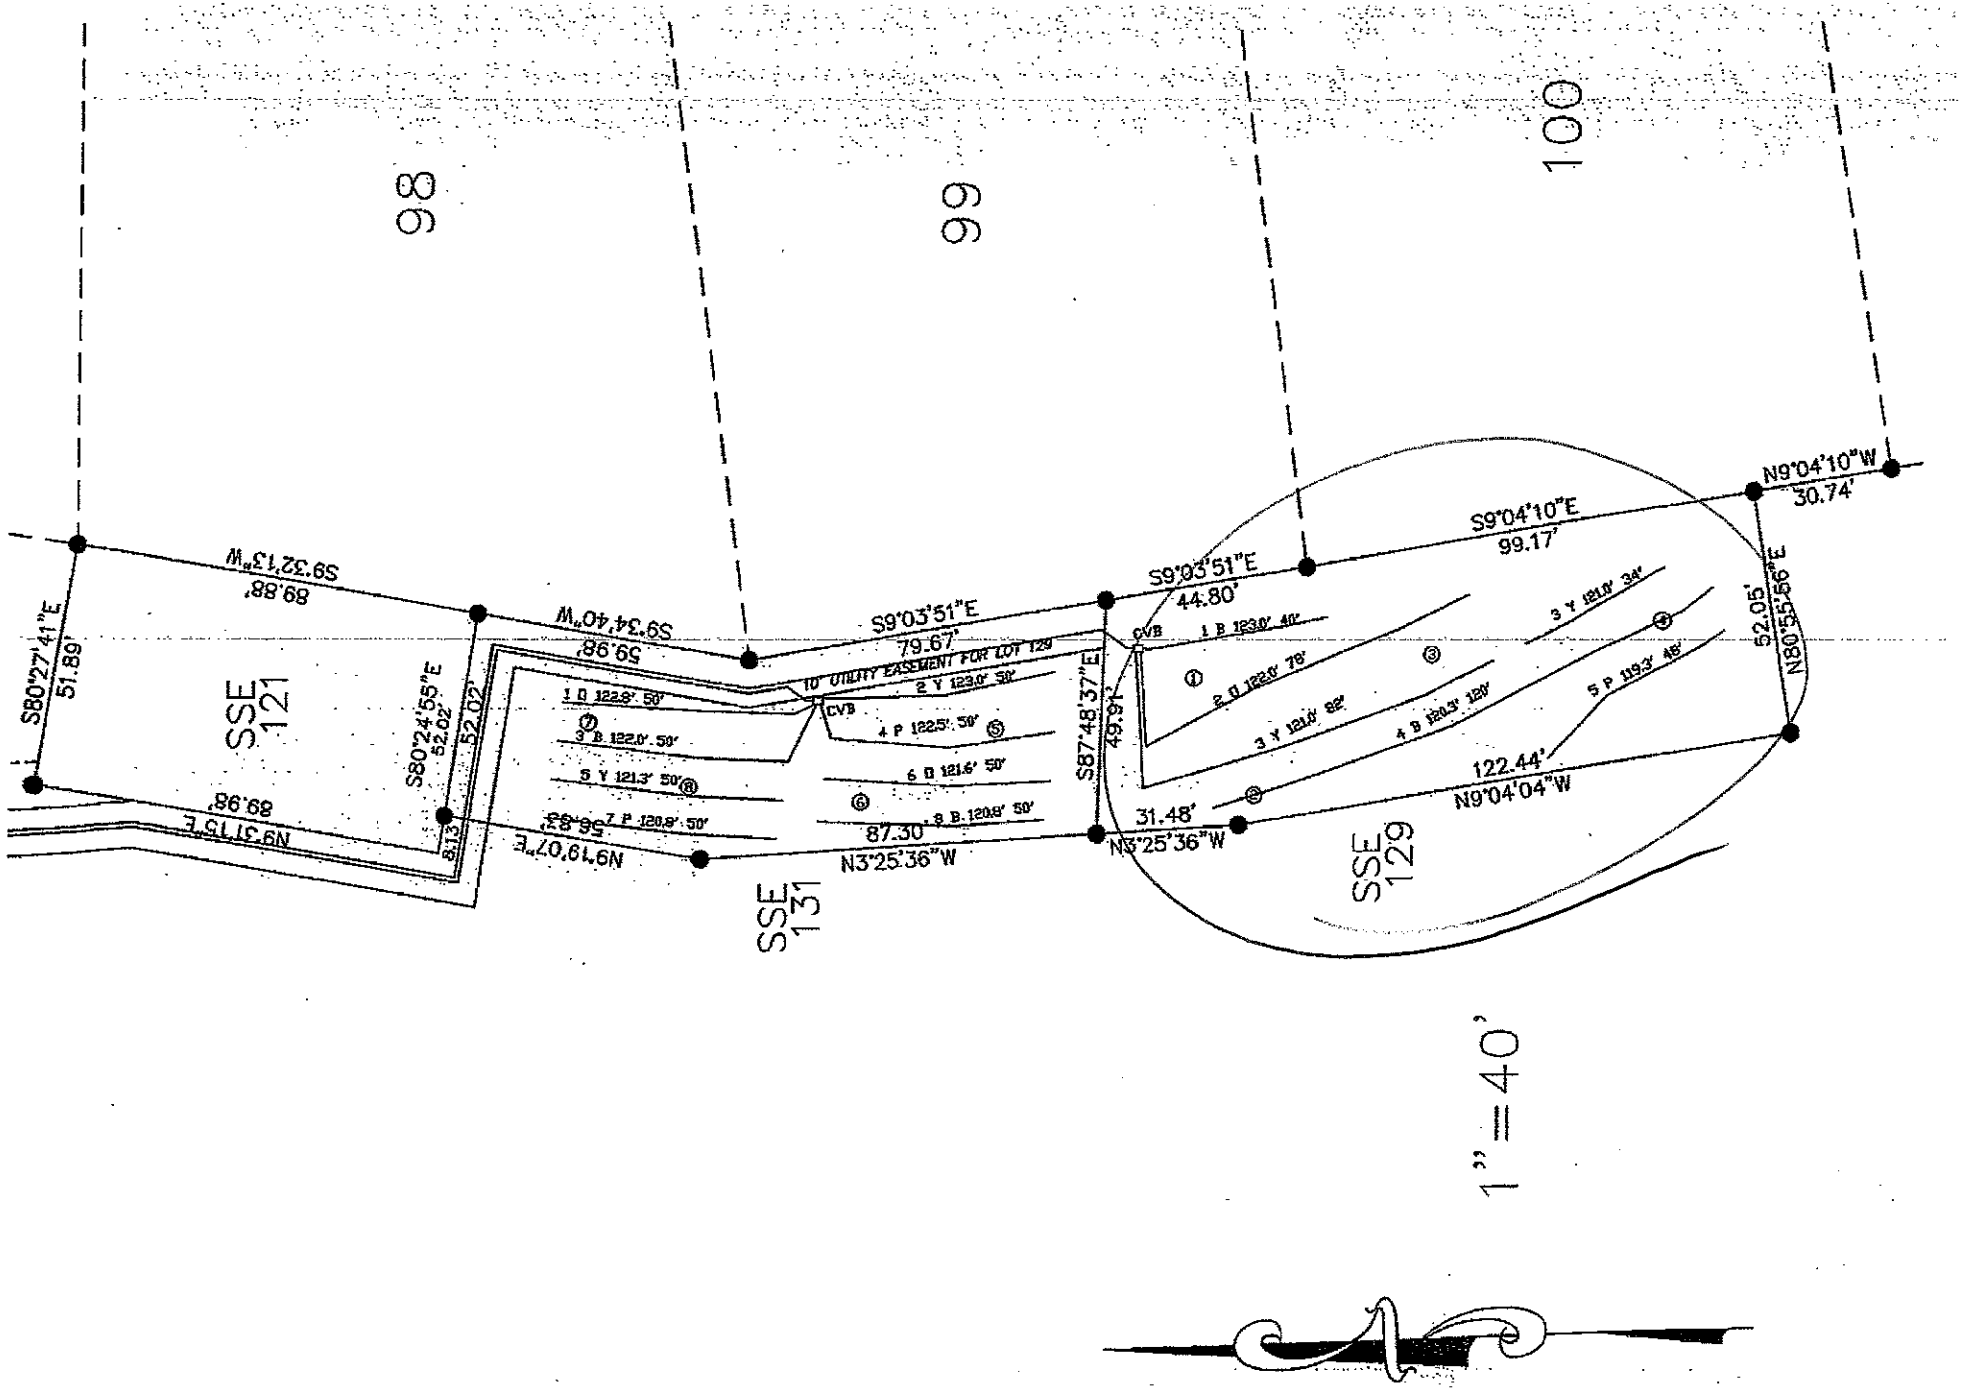
98
99
100
SSE 121
SSE 131
SSE 129
S80°27'41"E
51.89'
S9°32'13"W
89.88'
S9°34'40"W
59.98'
S9°03'51"E
79.67'
10' UTILITY EASEMENT FOR LOT 129
S9°03'51"E
44.80'
S9°04'10"E
99.17'
N9°04'10"W
30.74'
S87°48'37"E
49.91'
N80°55'56"E
52.05'
S80°24'55"E
52.02'
52.02'
8.13'
N9°19'07"E
56.83'
N9°31'15"E
89.98'
87.30'
N3°25'36"W
31.48'
N3°25'36"W
122.44'
N9°04'04"W
CVB
CVB
1 D 122.8' 50'
2 Y 123.0' 50'
3 B 122.0' 50'
4 P 122.5' 50'
5 Y 121.3' 50'
6 D 121.6' 50'
7 P 120.8' 50'
8 B 120.9' 50'
1 B 123.0' 40'
2 D 122.0' 78'
3 Y 121.0' 82'
3 Y 121.0' 34'
4 B 120.3' 120'
5 P 119.3' 48'
1" = 40'