TR-8423

IREDELL COUNTY HEALTH DEPARTMENT

STATESVILLE 704-878-5305 MOORESVILLE 704-664-5281

IMPROVEMENT PERMIT / CERTIFICATE OF COMPLETION / OPERATION PERMIT / EXISTING SYSTEM INSPECTI

PROPERTY DESCRIPTION NO. 25733 DATE 6/24/97 TAX MAP NO. 2K-9-4-142 4636 96 3608 Watershed: ☑ Yes ☐ No

OWNER OR CONTRACTOR ARTHUR SMETHERS PHONE: Business _____ Home 892-6298

ADDRESS 21033 TORRENCE CHAPEL RD / CORNELIUS

LOCATION BRAWLEY SCHOOL RD - TL CANVASBACK - TR OLD SQUAW - TL BILLY JOE'S BLVD TR PINTAIL ON RIGHT

SUBDIVISION MALLARD HEAD BLOCK / SECTION 1 LOT 142 LOT AREA - SITE CLASS. RS DESIGN FLOW 360 GAD L.T.A.R. .36 PD/FT2

Septic Tank: 1000 Gallons; STB 1015 Date 4/14/97

Pump Tank: 1000 Gallons; PT 17 Date 5/7/97

Pump Make: MYERS Model ME 40 MC-11 Serial No. 25360011

Nitrification Field: No Fields 1 Square Feet 400 Linear Feet 210

No Lines 7@30' Trench Width 24" Max Trench Bottom Depth 36" Gravel Depth N/A

☑ New System ☐ Repair System Type: I, II, III, IV, V, VI

System Description: PUMP PANEL

Repair System Description: DECKED 1978 - SOME PANEL

Maintenance Agreement Required: ☐ Yes ☑ No

☑ House/Mod. Home No. Bedrooms 3

☐ Mobile Home No. Bathrooms 2.5

☐ Business No. Employees ____

☐ Other _____


☐ Slab ☑ Crawl Space ☐ Basement w/plumbing ☐ Basement wo/plumbing

Water Supply: ☐ Individual ☑ Community ☐ Public


Comments:

Comments: LINES TANKS PRESSURE CHECKED COP
10/16/97 - Replaced 5 panels and pipe across
Pipe trenched through the trailfield. -ASIS

INITIAL SITE SKETCH

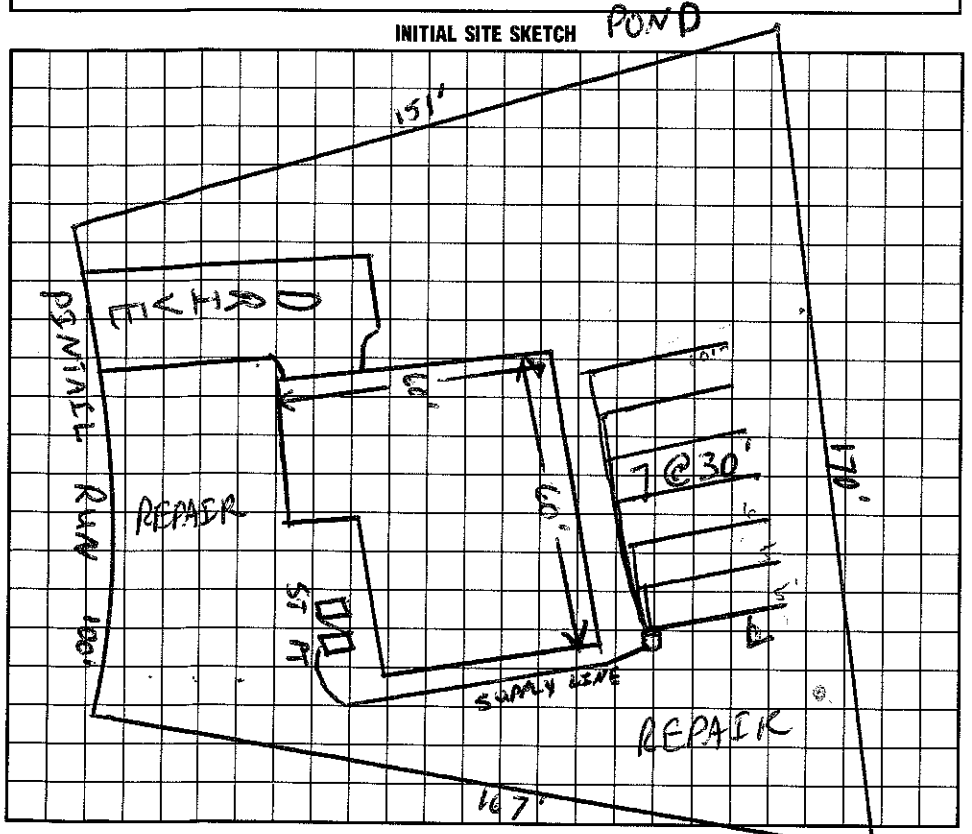

AS BUILT SKETCH

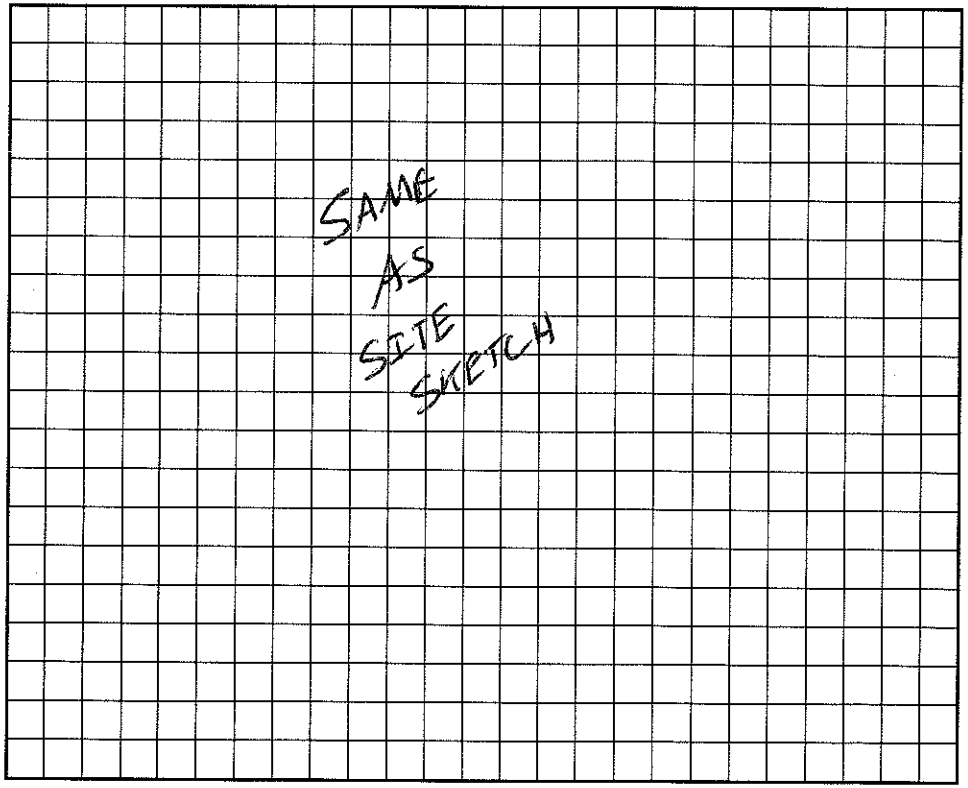

I understand that this permit can be suspended or revoked if any false information is supplied toward securing the permit/any unauthorized changes are made to the site/any unauthorized changes are made in the installation of the system. Improvement Permit is valid for 60 months from date of issuance.

Signed: _____

Improvement Permit by: C. [signature] date 6/24/97

Existing System Inspection by: C. [signature] date 6/24/97

Installed by: RICHARD ABERNATHY

Certificate of Completion by: Wesley Sparks R.S. date 7/16/97

Operation Permit by: Wesley Sparks R.S. date 7/16/97

HEALTH DEPT. COPY: WHITE INSPECTION COPY (FINAL): GREEN OWNER COPY (FINAL): YELLOW INSPECTION COPY (INITIAL): PINK OWNER COPY (INITIAL): GOLD