IREDELL COUNTY HEALTH DEPARTMENT

STATESVILLE 704-878-5305 — 375.00 Paid — MOORESVILLE 704-664-5281

IMPROVEMENT PERMIT / AUTHORIZATION TO CONSTRUCT / OPERATION PERMIT / EXISTING SYSTEM INSPECTION

PERMIT# 109068 PIN# 4636-76-5624 DATE 3/7/03

OWNER OR CONTRACTOR Realty Lake & Land / Patrick Indries PHONE: Business 704-439-2225 Home

ADDRESS 18 708W Catawba Ave, Cornelius NC 28031

LOCATION Brawley Sch, TL Canvasback, TR Old Squaw, TL Billy Joe, TR Pintail Run, on Rt

SUBDIVISION Mallard Head BLOCK / SECTION LOT 140/140A LOT AREA 0.459 AC Lot / 0.085 AC Easement SITE CLASS. PS DESIGN FLOW 360 L.T.A.R. 0.3

Septic Tank: 1000 Gallons; STB 97 Date 11/11/04
Pump Tank: 1060 Gallons; PT 71 Date 4/1/05
Pump Make: Myers Model ME-10052J Serial No. 5169
Nitrification Field: No Fields 1 Square Feet 800 Linear Feet 200'
No Lines 3@67' Trench Width 24" Max Trench Bottom Depth 36" Gravel Depth —

☒ New System ☐ Repair System Type: I, II, III, IV, V, VI
System Description: LP Pearl Block
Repair System Description: Same
Maintenance Agreement Required: ☒ Yes ☐ No

☒ House/Mod. Home No. Bedrooms 3
☐ Mobile Home No. Bathrooms 2
☐ Business No. Employees
☐ Other

☐ Slab ☒ Crawl Space ☐ Basement w/plumbing ☐ Basement wo/plumbing


Water Supply: ☐ Individual ☐ Public ☒ Community

Comments:/Conditions:


* - Supply line need to be 18"± below Irrigation line

Comments:/Conditions:

INITIAL SITE SKETCH

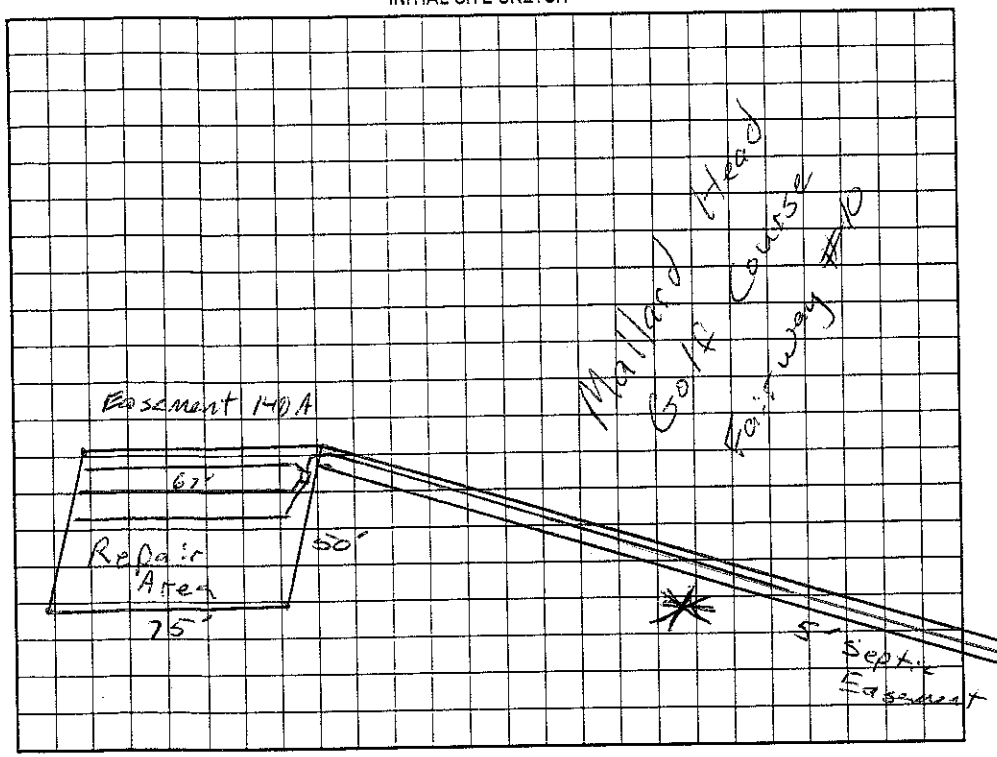

AS BUILT SKETCH

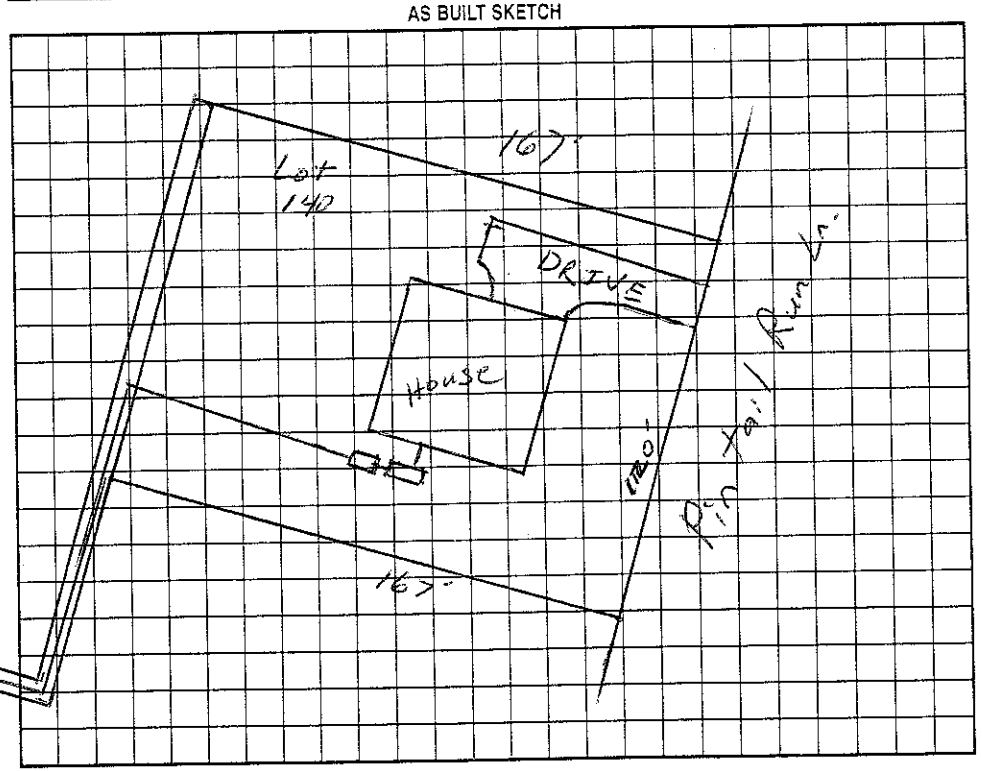

Permit can be suspended or revoked if any false information is supplied toward securing the permit/any unauthorized changes are made to the site/any unauthorized changes are made in the installation of the system. Improvement Permit with plat valid without expiration. Improvement Permit with site plan valid for sixty months. Authorization to Construct is valid for a period equal to that of Improvement Permit – not to exceed sixty months.

Signed: Peggy Davidson date 3/24/03 Installed by: WT Norwood

Improvement Permit by: RS date 3/7/03 Operation Permit by: Wesley Sparks RS. date 8/23/05

RS date 12/7/04 Existing System Inspection by: date

HEALTH DEPT. COPY: WHITE OWNER COPY (FINAL): YELLOW OWNER COPY (INITIAL): PINK