IREDELL COUNTY HEALTH DEPARTMENT

STATESVILLE 704-878-5305 MOORESVILLE 704-664-5281

IMPROVEMENT PERMIT / AUTHORIZATION TO CONSTRUCT / OPERATION PERMIT / EXISTING SYSTEM INSPECTION

PERMIT# 088580 PIN# 4636 76 ~~6651~~ 6682 DATE 5/25/00

OWNER OR CONTRACTOR Chuck Lineberry PHONE: Business 333-8000 Home

ADDRESS 811 Central Ave Charlotte NC. 28204

LOCATION 1100, TL Conway back TR Old Squaw TL Belly Joe TR Pintail Run on (R) x creek #136 Pintail

SUBDIVISION MALLARD HEAD BLOCK / SECTION LOT 134 LOT AREA .46 SITE CLASS. PS DESIGN FLOW 480 L.T.A.R. .3 (EASEMENT)

Septic Tank: 1000 Gallons; STB 794 Date 12/23/00
Pump Tank: 1000 Gallons; PT 238 Date 1/15/01
Pump Make: ~~FAIRCHILD~~ HYDROMATIC Model SHEF 100 H2 Serial No. 1/01
Nitrification Field: No Fields 1 Square Feet 800 Linear Feet * 267
No Lines 6 @ 45' x 3' Trench Width 36" Max Trench Bottom Depth 36" ~~Gravel Depth~~ SAND.


☑ New System ☐ Repair System Type: I, II, III, (IV), V, VI
System Description: 16" PPBS - LPP DISTRIBUTION
Repair System Description: SAME
Maintenance Agreement Required: ☒ Yes ☐ No

☒ House/Mod. Home No. Bedrooms 4
☐ Mobile Home No. Bathrooms 4
☐ Business No. Employees
☐ Other
☐ Slab ☐ Crawl Space ☐ Basement w/plumbing ☐ Basement wo/plumbing

Water Supply:
☐ Individual
☐ Public
☒ Community

Comments:/Conditions: FAIRWAY AREA

INITIAL SITE SKETCH

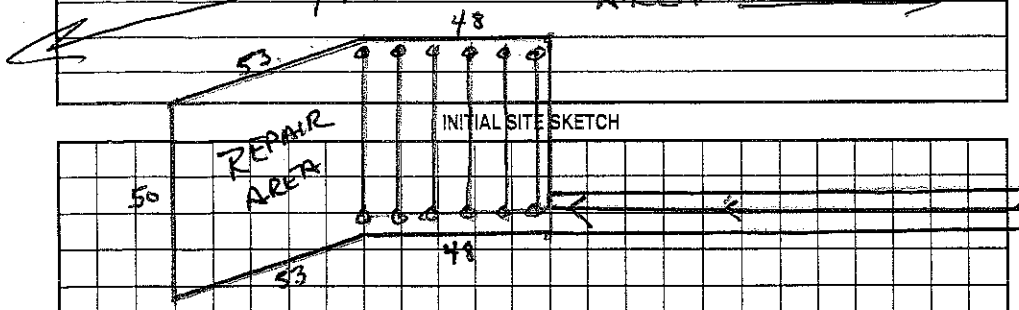

Comments:/Conditions:

AS BUILT SKETCH

The proposed / existing Detached Garage addition does not appear to impact the existing septic system.
**NOTE: Must keep Maint Agreement in Effect
Certified Mail Letter R.S.
WW Operation
Date: 4/16/2012
ICHD-Environmental Health Division

Permit can be suspended or revoked if any false information is supplied toward securing the permit/any unauthorized changes are made to the site/any unauthorized changes are made in the installation of the system. Improvement Permit with plat valid without expiration. Improvement Permit with site plan valid for sixty months. Authorization to Construct is valid for a period equal to that of Improvement Permit – not to exceed sixty months.

Signed: [signature] date 6-8-00 Installed by: Mallard Const.

Improvement Permit by: Wesley Sparks R.S. date 5/25/00 Operation Permit by: Wesley Sparks R.S. date 5/11/01

Authorization to Construct by: Wesley Sparks R.S. date 5/25/00 Existing System Inspection by: date

HEALTH DEPT. COPY: WHITE OWNER COPY (FINAL): YELLOW OWNER COPY (INITIAL): PINK