IREDELL COUNTY HEALTH DEPARTMENT

Statesville Office (704) 878-5305 Mooresville Office (704) 660-3625 PERMIT # 180609

IMPROVEMENT PERMIT / AUTHORIZATION TO CONSTRUCT / OPERATION PERMIT / EXISTING SYSTEM

PIN # 4636-76-8020

APPLICANT: RICHARD TOMASINI APPLICANT ADDRESS: 121 SPRING RUN DR. - Mooresville

SITE ADDRESS: SAME PHONE: 704-578-4951 ALT. PHONE:

SITE DIRECTIONS: BSR, TL MALLARD WAY, TL TEAL DR., TL PINTAIL, TR SPRING RUN, ON L

SUBDIVISION: MALLARD HEAD C.C.L.W.P. SECTION: 1 LOT # 131 LOT AREA: .49 AC DESIGN FLOW: 360 L.T.A.R.: .3

Septic Tank 1000 (gal) STB 1012 Date 9/2/15
Pump Tank 1000 (gal) PT 17 Date 7/5/16
Pump Make Bolles Model WEO-712Ha Serial #
Nitrification Fields 1 # Lines 4 Linear Ft: 200'
Trench Width 24" Max. Trench Bottom Depth 36" Gravel Depth —

☒ New System ☐ Repair ☐ Expansion System Type: I II III (IV) V VI
System Description: LP-PANEL BLOCK
Repair System Description: SAME
Maintenance Agreement Required: ☒ YES ☐ NO
☐ GRAVITY ☒ PRESSURE

☒ Residence No. Bedrooms 3
☐ Business No. Persons
☑ Other No. Employees
☐ Slab ☒ Crawl Space
☐ Basement w/plumbing ☐ Basement w/o plumbing

Water Supply: ☐ Private ☐ Public ☒ Community

Comments / Conditions:

POOL

INITIAL SITE SKETCH

Off site Septic System

SEE PLAN FROM CAROLINA SOIL & SEPTIC CONSULTING (SYSTEM DESIGN) & THE OAKS GROUP (POOL LOCATION)

AS BUILT SKETCH

DRAIN LINES CHECKED AUGUST 2014 JA

Permit can be suspended or revoked if any false information is supplied toward securing the permit / any unauthorized changes are made to the site / any unauthorized changes are made in the installation of the system. **CONTACT A LOCATOR SERVICE PRIOR TO ANY EXCAVATION**

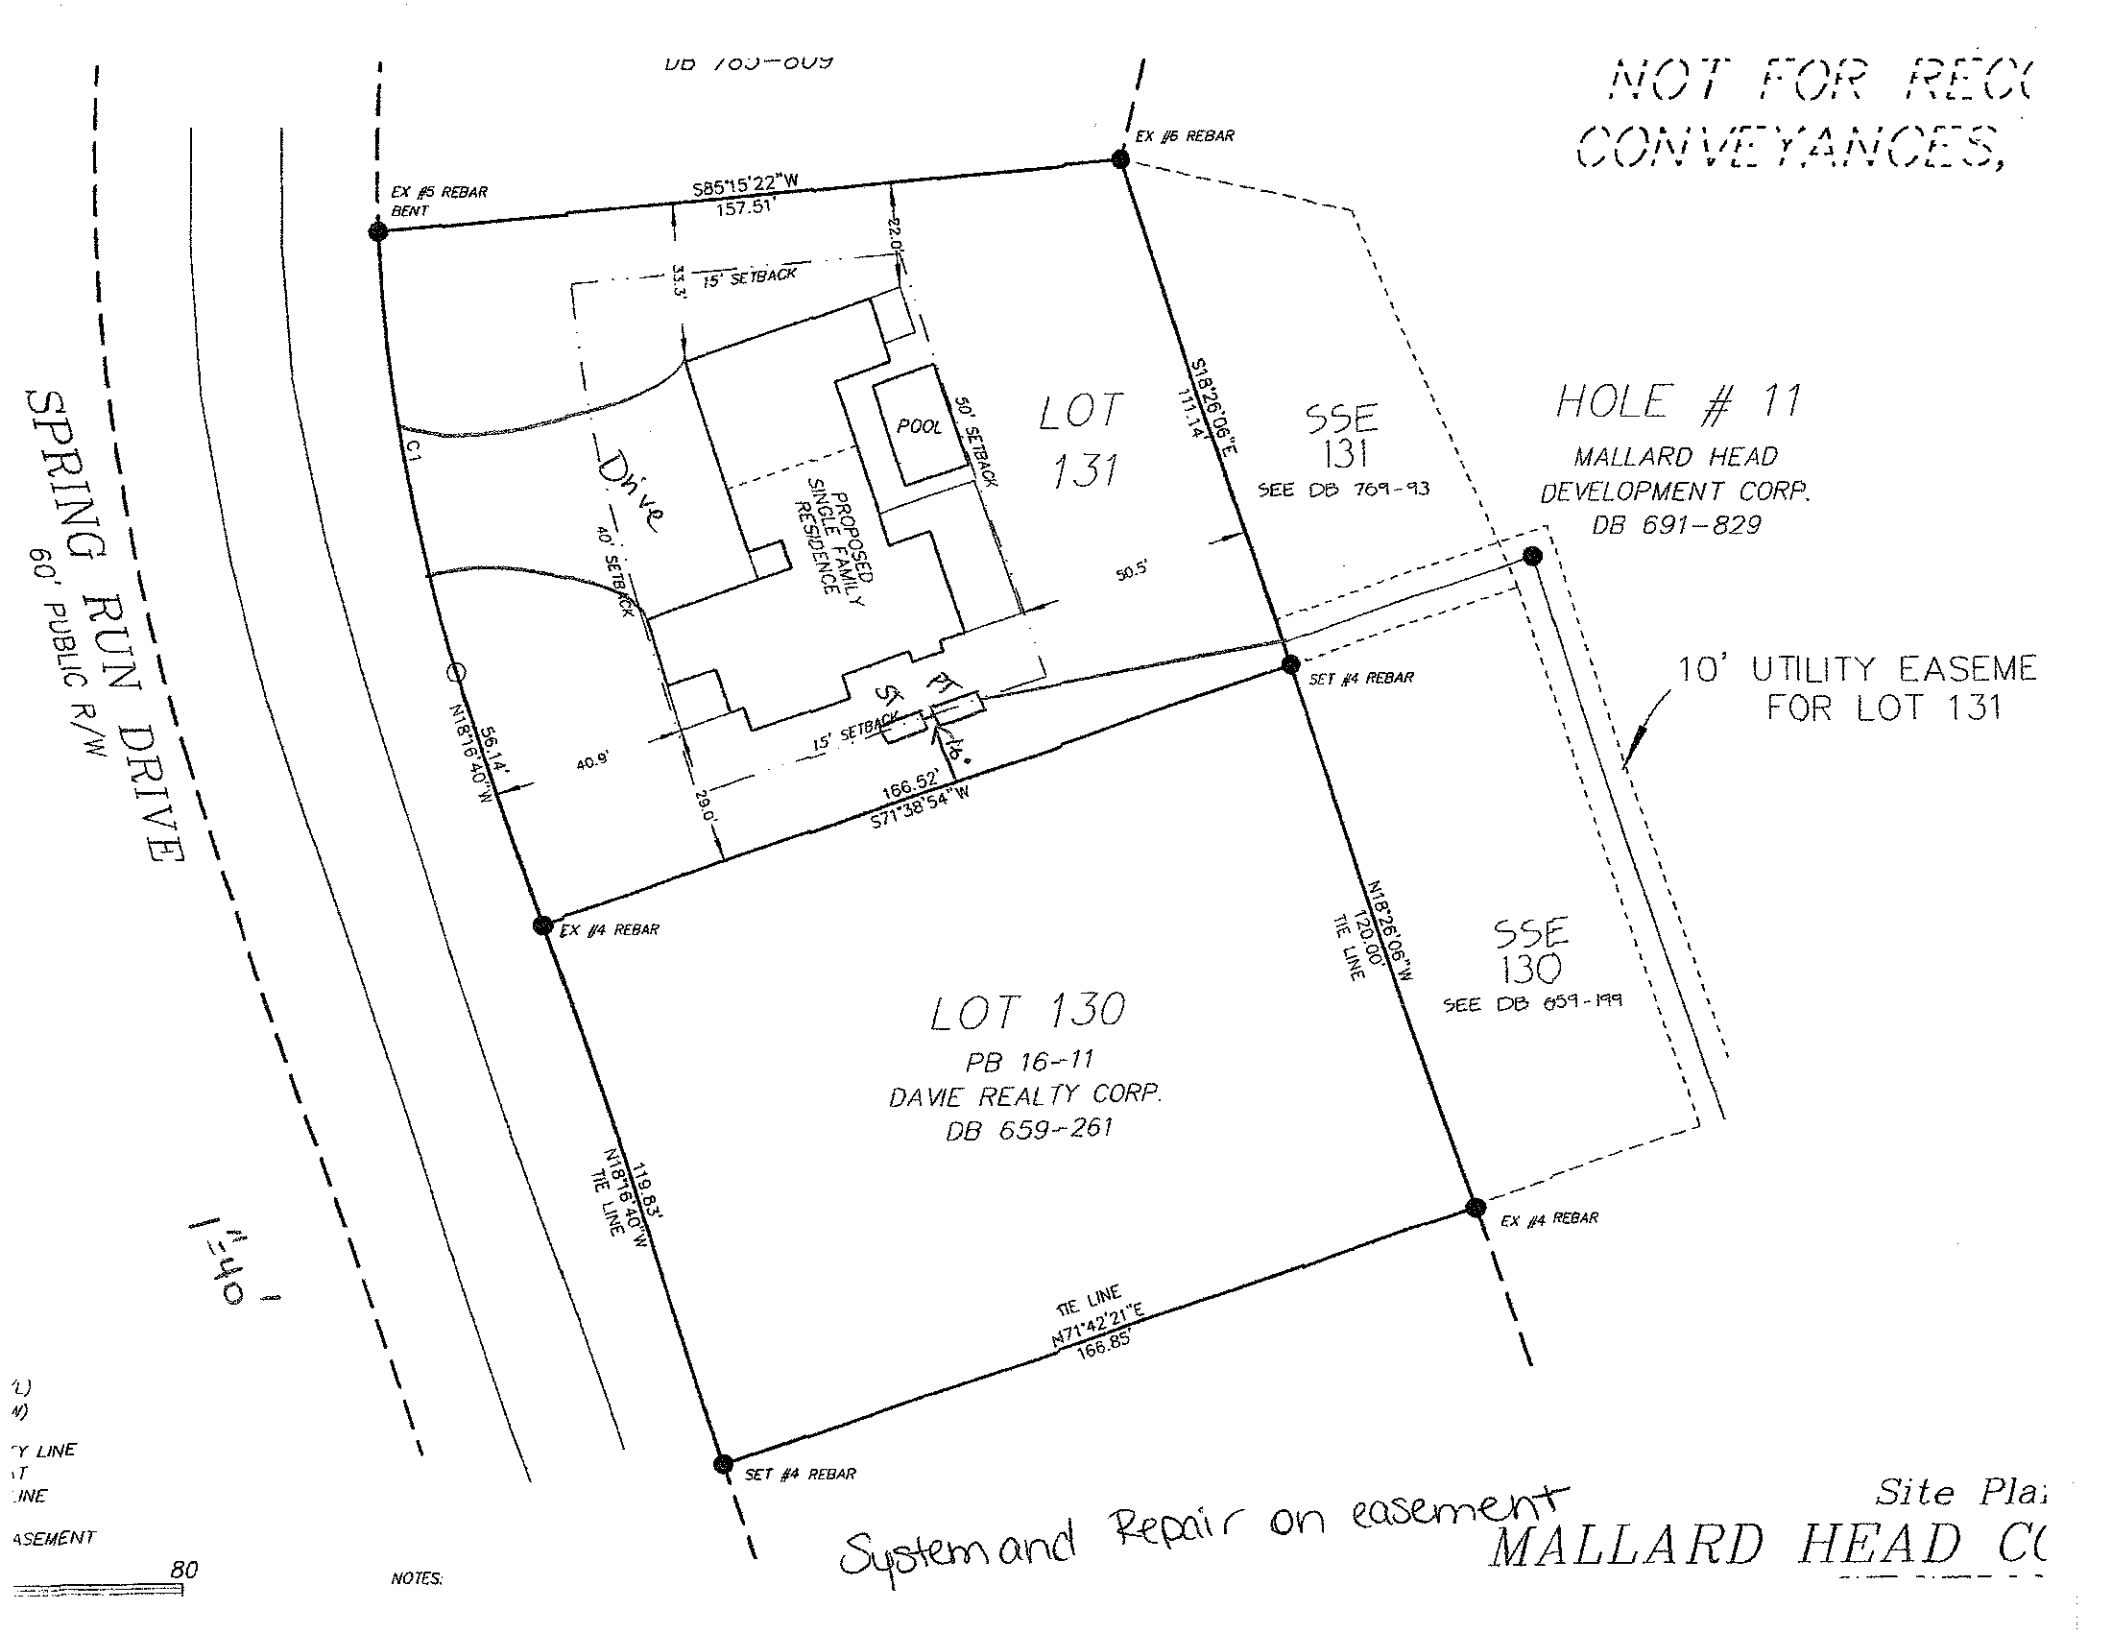
☐ **IMPROVEMENT PERMIT** *with plat valid without expiration.* ☐ **IMPROVEMENT PERMIT** *with site plan valid for 60 mos.* ☒ **AUTHORIZATION TO CONSTRUCT** *valid for period equal to IMPROVEMENT PERMIT--not to exceed 60 mo.*

Owner / Applicant Signature: [signature] Date: 7-11-16 Installed by: [signature]

IMPROVEMENT PERMIT by: [signature] Date: APPROVED JUN 10 2016 OPERATION PERMIT by: [signature] Date: 10/12/16

AUTHORIZATION TO CONSTRUCT by: [signature] Date: APPROVED JUN 10 2016 Existing System Inspected by: Date:

Health Dept. Copy - WHITE Applicant (Final Approval) - YELLOW Applicant (Conditional Approval) - PINK


NOT FOR REC
CONVEYANCES,
DB 765-009
EX #6 REBAR
EX #5 REBAR
BENT
S85°15'22"W
157.51'
22.0'
33.3'
15' SETBACK
POOL
50' SETBACK
LOT
131
S18°26'06"E
111.14'
SSE
131
SEE DB 769-93
HOLE # 11
MALLARD HEAD
DEVELOPMENT CORP.
DB 691-829
Drive
40' SETBACK
PROPOSED
SINGLE FAMILY
RESIDENCE
50.5'
10' UTILITY EASEME
FOR LOT 131
SET #4 REBAR
56.14'
40.9'
15' SETBACK
29.0'
166.52'
S71°38'54"W
EX #4 REBAR
N18°26'06"W
120.00'
TIE LINE
SSE
130
SEE DB 659-199
LOT 130
PB 16-11
DAVIE REALTY CORP.
DB 659-261
119.83'
N18°26'40"W
TIE LINE
EX #4 REBAR
TIE LINE
N71°42'21"E
166.85'
SET #4 REBAR
SPRING RUN DRIVE
60' PUBLIC R/W
1"=40'
80
NOTES:
System and Repair on easement
Site Pla
MALLARD HEAD C

97
98
99
S9°32'13"W
89.88'
S80°27'41"E
51.89'
S9°34'40"W
59.98'
S80°24'55"E
52.02'
52.02'
SSE
121
S9°03'51"E
79.67'
S9°03'51"E
44.80'
10' UTILITY EASEMENT FOR LOT 129
CVB
1 B 123.0' 40'
2 Y 123.0' 50'
1 D 122.8' 50'
4 P 122.5' 50'
3 B 122.0' 50'
5 Y 121.3' 50'
6 D 121.6' 50'
7 P 120.8' 50'
8 B 120.8' 50'
S87°48'37"E
49.91'
31.48'
N3°25'36"W
87.30'
N3°25'36"W
N89°31'15"E
89.98'
8.13
N9°19'07"E
56.83'
10' UTILITY EASEMENT FOR LOT 121
10' UTILITY EASEMENT FOR LOT 129 & 131
SSE
131
1" = 40'