IREDELL COUNTY HEALTH DEPARTMENT

STATESVILLE 704-878-5305 325.00 Paid MOORESVILLE 704-663-528[illegible]

IMPROVEMENT PERMIT / AUTHORIZATION TO CONSTRUCT / OPERATION PERMIT / EXISTING SYSTEM INSPECTION

11632 0

PERMIT# 088579 PIN# 4636 77 0713 DATE 1/22/01

OWNER OR CONTRACTOR Mountain Brook Homeworks PHONE: Business 704-361-7126 Home

ADDRESS 2464 Penngate Shelby Ford, NC 28673

LOCATION 1100 (L) Contrary Creek TR Webbed Foot TL Bufflehead last lot on (R)

SUBDIVISION MALLARD HEAD BLOCK / SECTION LOT 17 LOT AREA .40 SITE CLASS. PS DESIGN FLOW 360 L.T.A.R. .3

Septic Tank: 1000 Gallons; STB 1012 Date 12/16/03

Pump Tank: 1000 Gallons; PT 17 Date 11/10/03

Pump Make: Cavco Model WPA-501 4 Serial No. 3036929

Nitrification Field: No Fields 1 Square Feet 400 Linear Feet 200

No Lines 4@50' Trench Width 2' * Max Trench Bottom Depth 3'

[X] New System [ ] Repair System Type: I, II, III, (IV), V, VI

System Description: PPBAS - Pressure Dosed

Repair System Description: Same

Maintenance Agreement Required: [X] Yes [ ] No

~~Gravel Depth~~ SAND [ ] Slab [X] Crawl Space [ ] Basement w/plumbing [ ] Basement wo/plumbing

[X] House/Mod. Home No. Bedrooms 3

[ ] Mobile Home No. Bathrooms 2.5

[ ] Business No. Employees


[ ] Other

Water Supply: [ ] Individual [ ] Public [X] Community

Comments:/Conditions: *PER SUPERVISOR INSTRUCTION 3' WIDTH RECOMMENDED

(1" = 40')

INITIAL SITE SKETCH

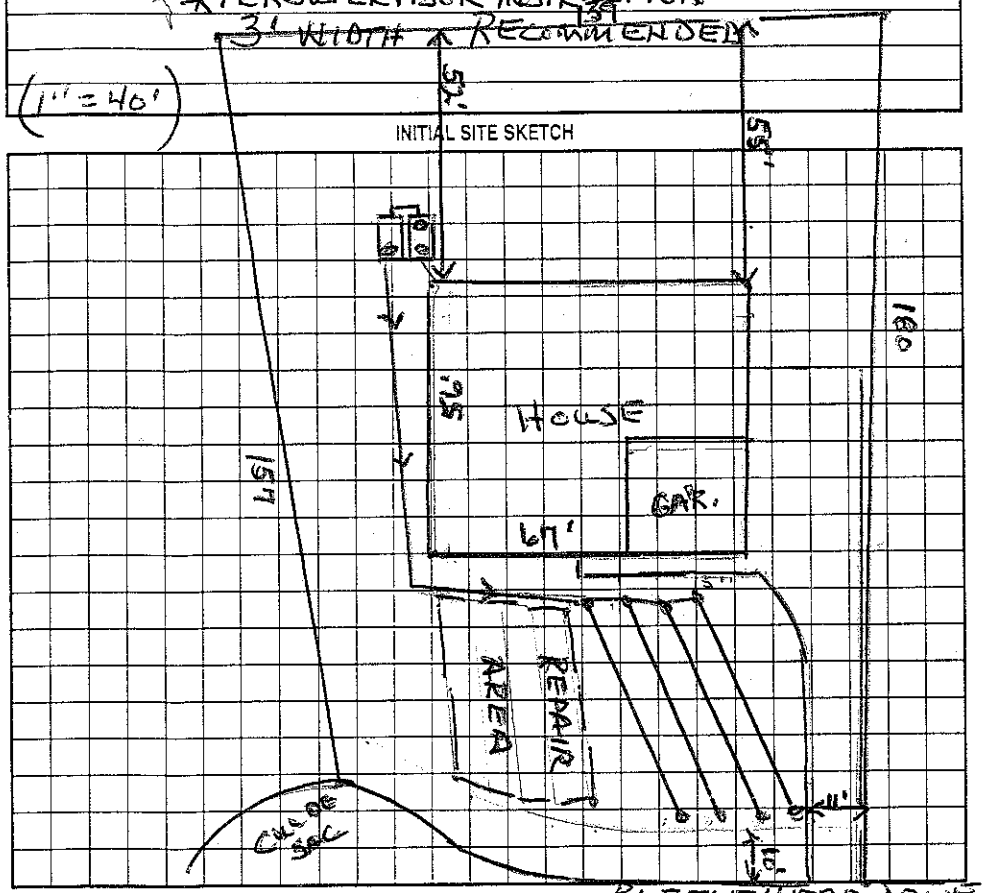

Comments:/Conditions:

AS BUILT SKETCH

The proposed KITCHEN - Pool House addition does not appear to impact the existing septic system.

**NOTE: PLUMBING MUST RUN THROUGH HOUSE SYSTEM

Wesley Sparks R.S.

Date: 3/31/04

ICHD-Environmental Health Division

Permit can be suspended or revoked if any false information is supplied toward securing the permit, any unauthorized changes are made to the site/any unauthorized changes are made in the installation of the system. Improvement Permit with plat valid without expiration. Improvement Permit with site plan valid for sixty months. Authorization to Construct is valid for a period equal to that of Improvement Permit – not to exceed sixty months.

Signed: * Barton Ramey Mowe date 1/29/01

Improvement Permit by: Wesley Sparks R.S. date 1/22/01

Authorization to Construct by: Wesley Sparks RS date 1/22/01

Installed by: A-1 Backhoe

Operation Permit by: Wesley Sparks R.S. date 10/20/04

Existing System Inspection by: date

HEALTH DEPT. COPY: WHITE OWNER COPY (FINAL): YELLOW OWNER COPY (INITIAL): PINK