IREDELL COUNTY HEALTH DEPARTMENT

STATESVILLE 704-878-5305 50.00 Paid MOORESVILLE 704-664-5281

IMPROVEMENT PERMIT / AUTHORIZATION TO CONSTRUCT / OPERATION PERMIT / EXISTING SYSTEM INSPECTION

PERMIT# 093102 PIN# 4636 77 5296 DATE 1/8/01

OWNER OR CONTRACTOR Teglord-Brown Const. Co. PHONE: Business 895-9652 Home

ADDRESS 7305 Windaliera Dr. Cornelius, NC 28031

LOCATION Brawley Sch. (L) on Conoesback (R) Old Statesville, at end.

SUBDIVISION Mallard Head BLOCK / SECTION LOT 47 LOT AREA .42 AC SITE CLASS. PS DESIGN FLOW 480 L.T.A.R. .3

Septic Tank: 1000 Gallons; STB 794 Date 4/18/01
Pump Tank: Gallons; PT Date
Pump Make: Model Serial No.
Nitrification Field: No Fields 1 Square Feet 800 Linear Feet 266
No Lines @ 3 Trench Width 36" Max Trench Bottom Depth 36" Gravel Depth SAND.

☒ New System ☐ Repair System Type: I, II, (III) IV, V, VI
System Description: GRAV - 16" PPBS
Repair System Description: PRES — 16" PPBS
Maintenance Agreement Required: ☐ Yes ☒ No


☒ House/Mod. Home No. Bedrooms 4
☐ Mobile Home No. Bathrooms 3
☐ Business No. Employees
☐ Other

☐ Slab ☐ Crawl Space ☒ Basement w/plumbing ☐ Basement wo/plumbing

Water Supply: ☐ Individual ☐ Public ☒ Community

Comments:/Conditions:

INITIAL SITE SKETCH

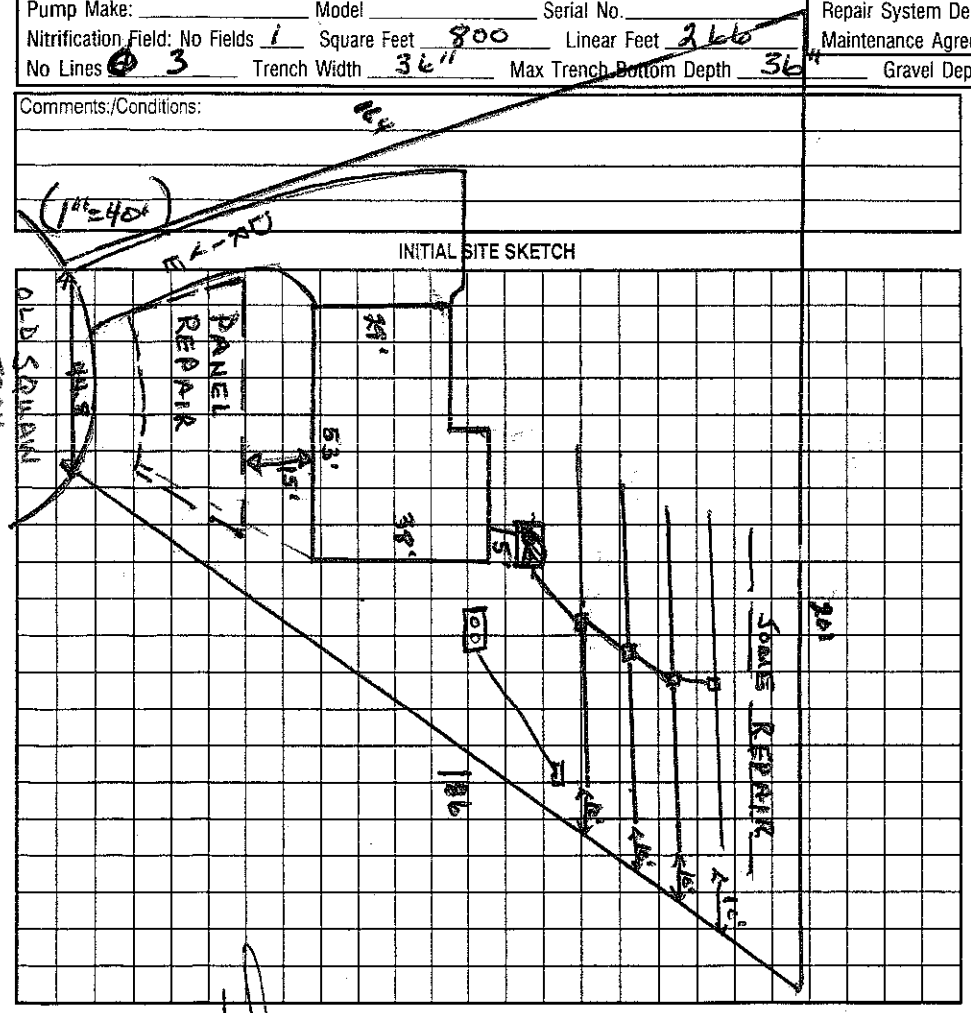

Comments:/Conditions:

AS BUILT SKETCH

Permit can be suspended or revoked if any false information is supplied toward securing the permit/any unauthorized changes are made to the site/any unauthorized changes are made in the installation of the system. Improvement Permit with plat valid without expiration. Improvement Permit with site plan valid for sixty months. Authorization to Construct is valid for a period equal to that of Improvement Permit – not to exceed sixty months.

Signed: ✗ W Brown date 1/9/01 Installed by: F.J. Erwin

Improvement Permit by: Wesley Sparks R.S. date 1/8/01 Operation Permit by: Wesley Sparks R.S. date 7/23/01

Authorization to Construct by: Wesley Sparks R.S. date 1/8/01 Existing System Inspection by: date

HEALTH DEPT. COPY: WHITE OWNER COPY (FINAL): YELLOW OWNER COPY (INITIAL): PINK