IREDELL COUNTY HEALTH DEPARTMENT

4636 77 9050

STATESVILLE 704-878-5305 MOORESVILLE 704-664-5281

IMPROVEMENT PERMIT / CERTIFICATE OF COMPLETION / OPERATION PERMIT / EXISTING SYSTEM INSPECTION

PROPERTY DESCRIPTION NO. DATE June 14, '93 TAX MAP NO.

OWNER OR CONTRACTOR John Dillon PHONE: Business Home 664-3874

ADDRESS

LOCATION 15 Old Saugus TRAIL off CANVAS back 60x80'

SUBDIVISION Mallard Head BLOCK / SECTION LOT 51 LOT AREA Sewer Easement SITE CLASS. L.T.A.R.

Water Supply: ☐ Individual ☑ Community ☐ Public

Septic Tank: Existing Gallons; STB Date

Pump Tank: Existing Gallons; PT Date

Nitrification Field: No Fields 1 EXT + 1 NEW Square Feet Linear Feet 200

No Lines 3 Trench Width 24" Trench Depth 30-36" Gravel Depth NA

☐ New System ☑ Repair System Type: I, II, III, IV, V, VI

System Description: LP panel

Repair System Description: LP panel

Maintenance Agreement Required: ☑ Yes ☐ No

☑ House/Mod. Home No. Bedrooms 4 Garbage Disposal: ☑ Yes ☐ No

☐ Mobile Home No. Bathrooms 2½ Auto. Dishwasher: ☑ Yes ☐ No


☐ Business No. Employees Auto. Washing Machine: ☑ Yes ☐ No

☐ Other Other

☐ Slab ☑ Crawl Space ☐ Basement w/plumbing ☐ Basement wo/plumbing

Comments Septic Tank Contractor to have consultation w/ me prior to installing repair system.

INITIAL SITE SKETCH

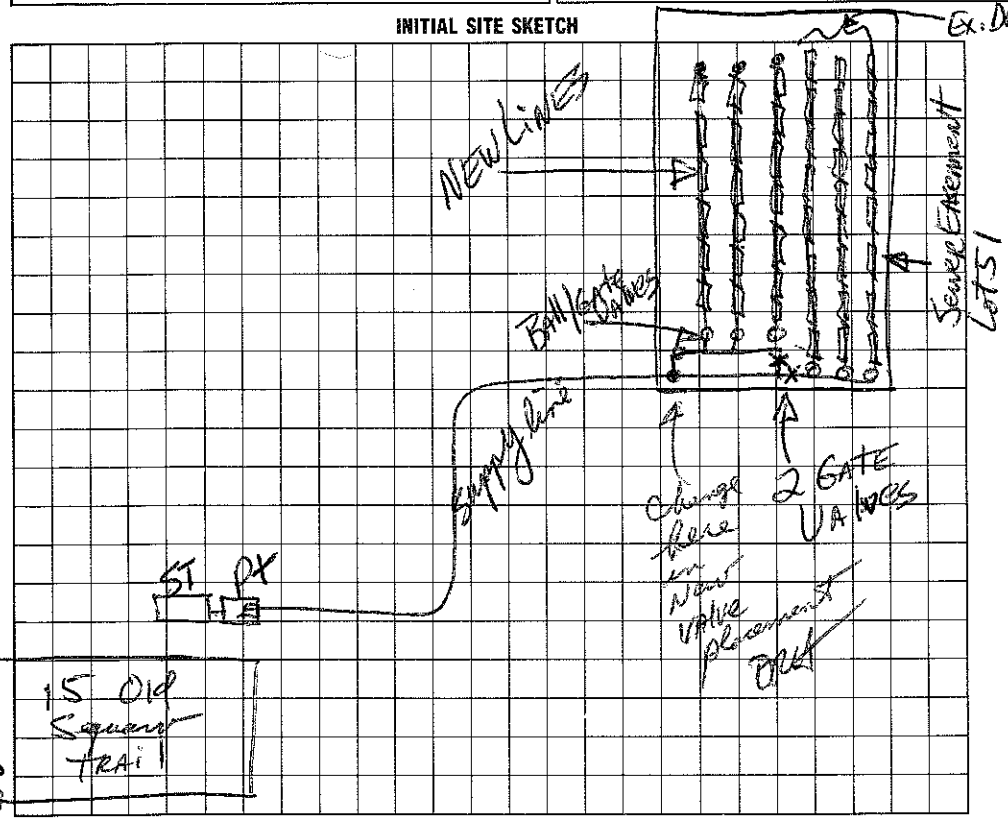

AS BUILT SKETCH

As shown on initial sketch except as noted.

I understand that this permit can be suspended or revoked if any false information is supplied toward securing the permit/any unauthorized changes are made to the site/any unauthorized changes are made in the installation of the system. Improvement Permit is valid for 60 months from date of issuance.

Signed: John R Dillon

Improvement Permit by: date 6/14/93

Existing System Inspection by: date

Installed by:

Certificate of Completion by: date

Operation Permit by: date Oct 5, '93

HEALTH DEPT. COPY: WHITE INSPECTION COPY (FINAL): GREEN OWNER COPY (FINAL): YELLOW INSPECTION COPY (INITIAL): PINK OWNER COPY (INITIAL): GOLD