As Built

IREDELL COUNTY HEALTH DEPARTMENT

STATESVILLE 704-878-5305 MOORESVILLE 704-664-5281

IMPROVEMENT PERMIT / AUTHORIZATION TO CONSTRUCT / OPERATION PERMIT / EXISTING SYSTEM INSPECTION

PERMIT# 129625 PIN# 4636779999 DATE 10-3-07

OWNER OR APPLICANT Wesley Loredon PHONE: Business 658-5106 Home

ADDRESS 106 Fantasy Ln Mooresville, NC

LOCATION Brawley School Rd TL Canvasback TR Webbed Foot on left @ intersection w/ Buffle Head

SUBDIVISION Mallard Head BLOCK / SECTION LOT 29 LOT AREA .5 Acre SITE CLASS. RS DESIGN FLOW 480 gpd L.T.A.R. .3

Septic Tank: 1000 Gallons: STB 825 Date 6-20-07

Pump Tank: Gallons: PT Date

Pump Make: Model Serial No.

Nitrification Field: No Fields 1 Square Feet 1200' Linear Feet 400'

No Lines 6 Trench Width 36" Max Trench Bottom Depth 36" Gravel Depth NA

☒ New System ☐ Repair ☐ Expansion System Type: I II III IV V VI

System Description: Gravity - 25% Reduction

Repair System Description: ☒ Partial Panel Blk

Maintenance Agreement Required: ☐ Yes ☒ No

☒ House/Mod. (Home ☐ Mobile Home ☐ Business ☐ Other

No. Bedrooms 4 No. Persons No. Employees

Water Supply: ☐ Individual ☒ Public ☒ Community

☒ Gravity ☐ Pressure ☐ Slab ☒ Crawl Space ☐ Basement w/plumbing ☐ Basement wo/plumbing


#135 per Builder on Comm well

Comments:/Conditions:

Comments:/Conditions: ☒ Lot deeded & recorded prior to 1983

Note: Installed Quick 4 for Drainfield used "Built in" drop boxes, last line connected to end of line above.

Scale 1:50 INITIAL SITE SKETCH

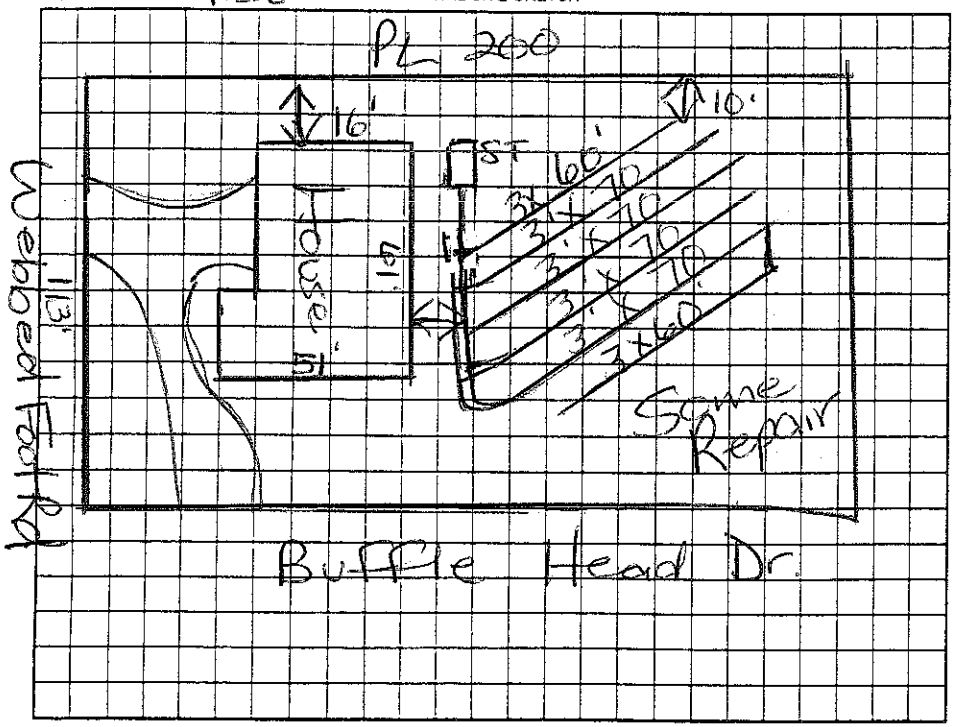

AS BUILT SKETCH

Permit can be suspended or revoked if any false information is supplied toward securing the permit/any unauthorized changes are made to the site/any unauthorized changes are made in the installation of the system. Improvement Permit with plan valid without expiration ☐ Improvement Permit with site plan valid for sixty months ☐ Authorization to Construct is valid for a period equal to that of Improvement Permit – not to exceed sixty months.

Signed: date 10/03/07

Improvement Permit by: RS date

Authorization to Construct by: RS date

Installed by: Rowan Septic

Operation Permit by: date 10/3/07 As Built

Existing System Inspection by: date

HEALTH DEPT. COPY: WHITE OWNER COPY (FINAL): YELLOW OWNER COPY (INITIAL): PINK

IREDELL COUNTY HEALTH DEPARTMENT

STATESVILLE 704-878-5305 MOORESVILLE 704-664-3281 2:00

IMPROVEMENT PERMIT / AUTHORIZATION TO CONSTRUCT / OPERATION PERMIT / EXISTING SYSTEM INSPECTION

PERMIT# 129625 PIN# 4636779999 DATE 8-8-05

OWNER OR CONTRACTOR Wesley Zdrenton PHONE: Business 658-5106 Home

ADDRESS 106 Fantasy Ln Mooresville, NC 28117

LOCATION Brawley School Rd TL Canvasback TR Webbed Foot on left at intersection w/Buffle Head #135

SUBDIVISION Mallard Head BLOCK / SECTION LOT 29 LOT AREA SITE CLASS. PS DESIGN FLOW 450gpd L.T.A.R. .3

Septic Tank: 1000 Gallons; STB 825 Date 6-26-07

Pump Tank: Gallons; PT Date

Pump Make: Model Serial No.

Nitrification Field: No Fields 1 Square Feet 1215 Linear Feet 405

No Lines 5 Trench Width 36" Max Trench Bottom Depth 36" Gravel Depth N/A

☒ New System ☐ Repair System Type: I (II) III, IV, V, VI

System Description: Gravity - 25% Reduction

Repair System Description: Partial - Panel Blk

Maintenance Agreement Required: ☐ Yes ☒ No

☒ House/Mod. Home No. Bedrooms 4

☐ Mobile Home No. Bathrooms 4

☐ Business No. Employees

☐ Other


☐ Slab ☒ Crawl Space ☐ Basement w/plumbing ☐ Basement wo/plumbing

Water Supply: ☒ Individual ☐ Public ☐ Community

Comments/Conditions: Keep well 50' to 100' from Septic System & 25' from house.


Scale 1:50'

INITIAL SITE SKETCH

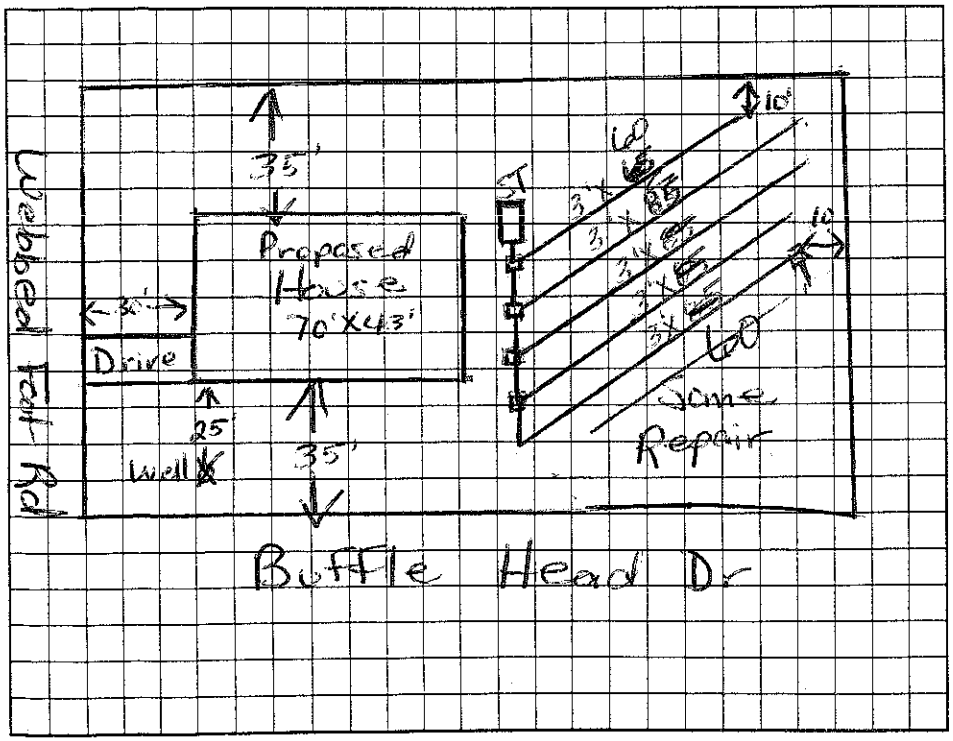

Comments/Conditions: ★ Lot deeded & recorded prior to 1983. 4/18/07 House will face Webbed Foot and should still fit Building Footprint.

AS BUILT SKETCH

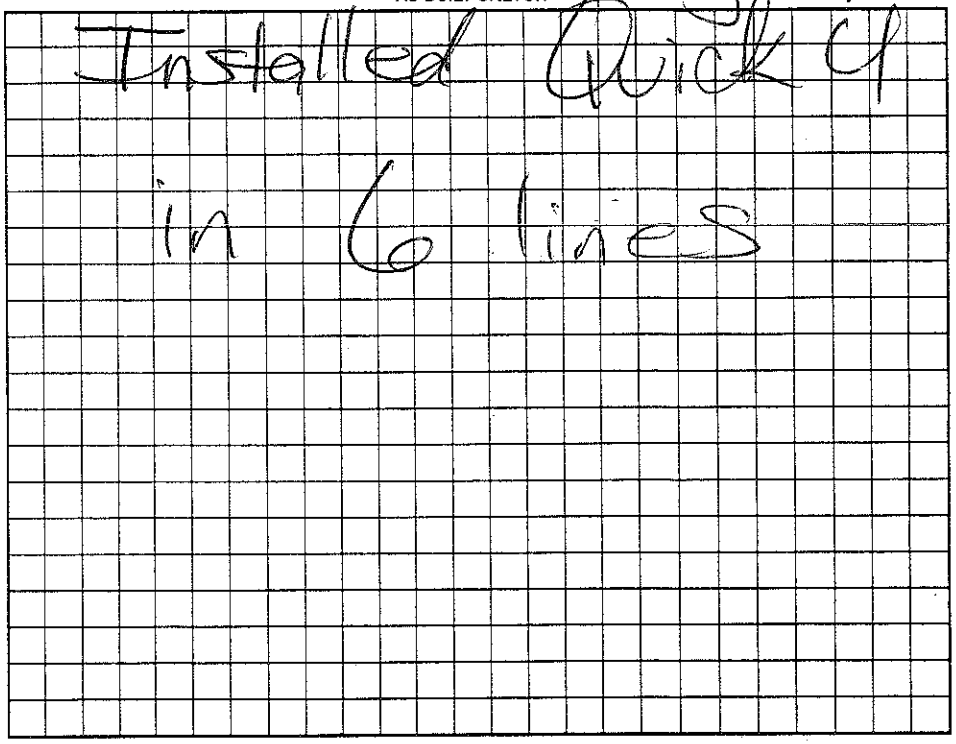

Permit can be suspended or revoked if any false information is supplied toward securing the permit/any unauthorized changes are made to the site/any unauthorized changes are made in the installation of the system. Improvement Permit with plat valid without expiration. Improvement Permit with site plan valid for sixty months. Authorization to Construct is valid for a period equal to that of Improvement Permit – not to exceed sixty months.

Signed: date 8/10/05

Improvement Permit by: Maina M. Dolan RS date 5/8/05

Authorization to Construct by: Maina M. Dolan RS date 5/8/05

Installed by: Rowan Septic

Operation Permit by: Maina M. Dolan RS date 8/16/07

Existing System Inspection by: date

HEALTH DEPT. COPY: WHITE OWNER COPY (FINAL): YELLOW OWNER COPY (INITIAL): PINK