IREDELL COUNTY HEALTH DEPARTMENT

STATESVILLE 704-878-5305 MOORESVILLE 704-664-5281

IMPROVEMENT PERMIT / AUTHORIZATION TO CONSTRUCT / OPERATION PERMIT / EXISTING SYSTEM INSPECTION

PERMIT# 150523 PIN# 4636781983 DATE 5-28-08

OWNER OR APPLICANT Jim Miller - Kamco Inc PHONE: Business 704-617-5162 Home

ADDRESS 939 Brawley School Rd Mooresville NC 28117

LOCATION Same 933 Brawley School Rd

~~SUBDIVISION~~ — Kamco Property BLOCK / SECTION — LOT — 1 LOT AREA .44Ac SITE CLASS. PS DESIGN FLOW 175 L.T.A.R. .35

Septic Tank: Existing Gallons: STB Date

Pump Tank: Gallons: PT Date

Pump Make: Model Serial No.

Nitrification Field: No Fields 1 Square Feet 540' Linear Feet 180'

No Lines 3@60' Trench Width Max Trench Bottom Depth Gravel Depth ☒ Gravity ☐ Pressure

☐ New System ☐ Repair ☐ Expansion System Type: I II III IV V VI

System Description: Existing Grav. Conven.

Repair System Description: Same

Maintenance Agreement Required: ☐ Yes ☒ No

☐ House/Mod. Home No. Bedrooms

☐ Mobile Home No. Persons

☒ Business No. Employees 7

☐ Other


Water Supply: ☒ Individual ☐ Public ☐ Community

☐ Slab ☒ Crawl Space ☐ Basement w/plumbing ☐ Basement wo/plumbing


Comments:/Conditions: If new well is drilled it must be min of 100' from septic & repair

Comments:/Conditions:

INITIAL SITE SKETCH

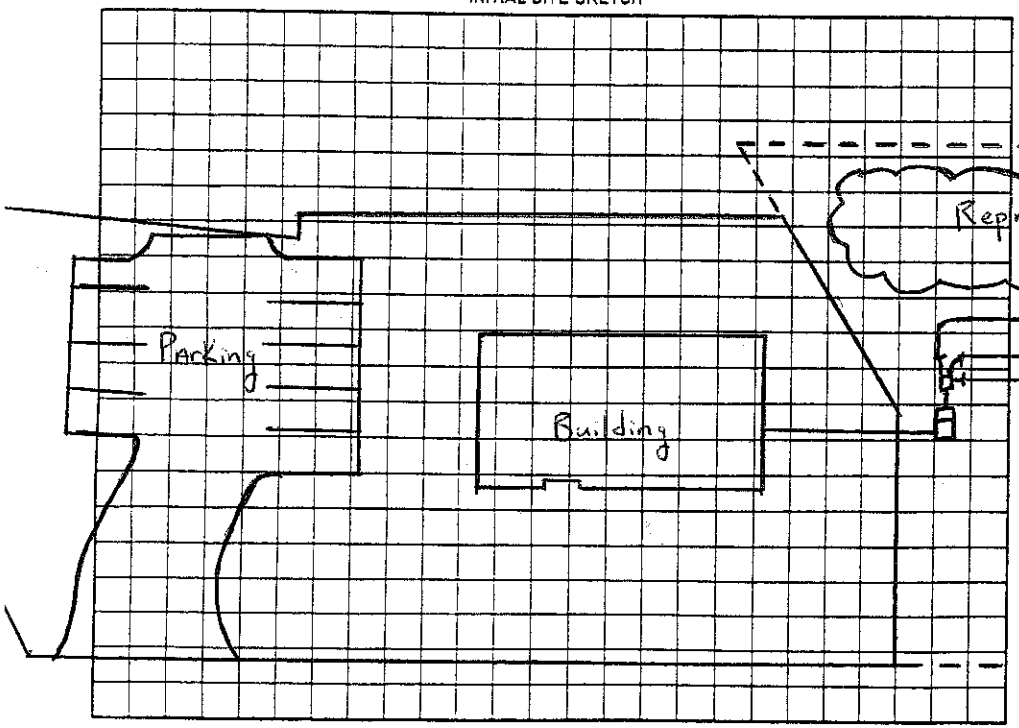

AS BUILT SKETCH

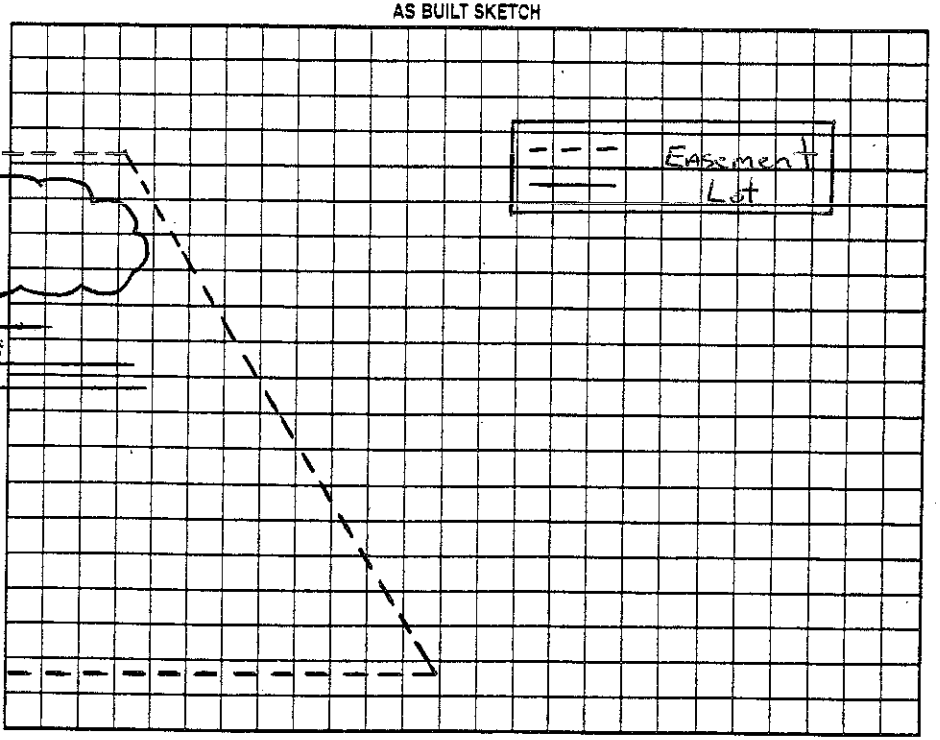

Permit can be suspended or revoked if any false information is supplied toward securing the permit/any unauthorized changes are made to the site/any unauthorized changes are made in the installation of the system. Improvement Permit with plat valid without expiration ☐ Improvement Permit with site plan valid for sixty months ☐ Authorization to Construct is valid for a period equal to that of Improvement Permit – not to exceed sixty months.

Signed: James Miller date 5/29/08 Installed by:

Improvement Permit by: date Operation Permit by: date

Authorization to Construct by: date Existing System Inspection by: R-Kelly date 5-28-08

HEALTH DEPT. COPY: WHITE OWNER COPY (FINAL): YELLOW OWNER COPY (INITIAL): PINK