IREDELL COUNTY HEALTH DEPARTMENT

STATESVILLE 704-878-5305 MOORESVILLE 704-664-5281

IMPROVEMENT PERMIT / AUTHORIZATION TO CONSTRUCT / OPERATION PERMIT / EXISTING SYSTEM INSPECTION

PERMIT# 106972 PIN# 4636 18 4856. 4636-88-0320 DATE 4/15/04

OWNER OR CONTRACTOR Wayne Walker PHONE: Business 704-361-3565 Home

ADDRESS 22113 Attilla Dr. Charlotte, NC. 28031

LOCATION 1100 TL Conover Loop TR Welsh Foot on (R) before sharp curve

SUBDIVISION ~~NEWPORT DEV.~~ BLOCK / SECTION 1 LOT 2 LOT AREA .69 Ac SITE CLASS PS DESIGN FLOW 480 L.T.A.R. .3

Wallace Road

Septic Tank: 1000 Gallons; STB 786 Date 7/31/04

Pump Tank: Gallons; PT Date

Pump Make: Model Serial No.

Nitrification Field: No Fields 1 Square Feet 534/801 Linear Feet 270

No Lines 4@70' Trench Width 2-3' Max Trench Bottom Depth 3' Gravel Depth No

[X] New System [ ] Repair System Type: I, II, (III), IV, V, VI

System Description Center Fed - 16" PPBPS

Repair System Description: Same

Maintenance Agreement Required: [ ] Yes [X] No

[X] House/Mod. Home No. Bedrooms 4

[ ] Mobile Home No. Bathrooms 3.5

[ ] Business No. Employees

[ ] Other


[ ] Slab [X] Crawl Space [ ] Basement w/plumbing [ ] Basement wo/plumbing

Water Supply: [ ] Individual [ ] Public [X] Community

Comments:/Conditions: 2' trenches on 8' centers 3' trenches on 9' centers Driveway may enter on right of garage provided it does not cut across drainfield and repair area shown on this permit.

Comments:/Conditions: Installed 16" PPBS as shown on AS

INITIAL SITE SKETCH

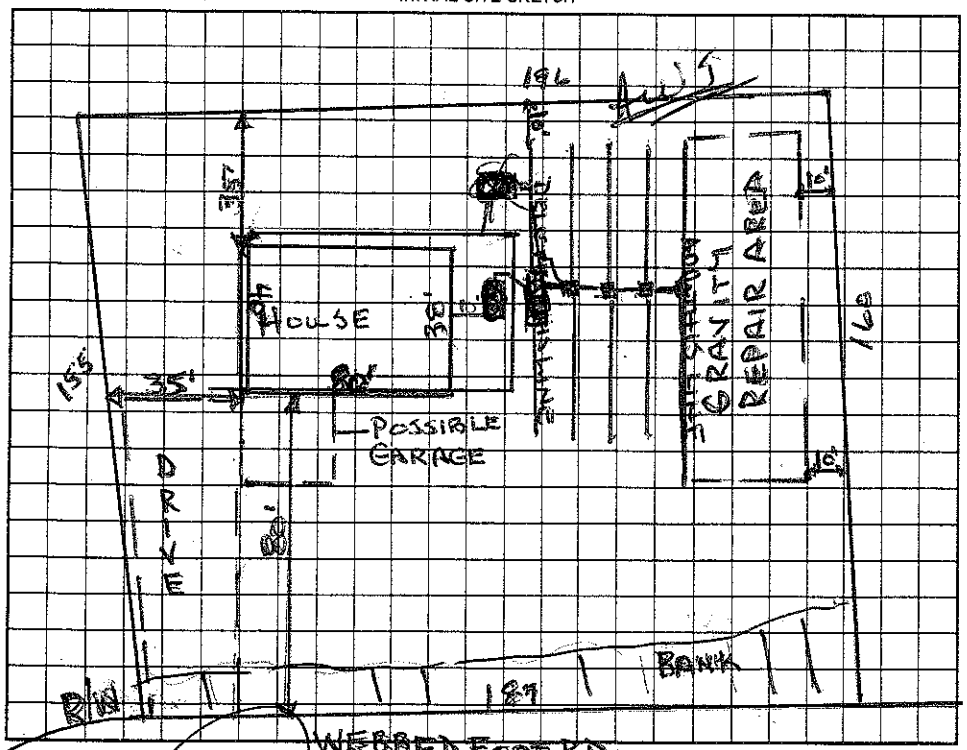

AS BUILT SKETCH

Permit can be suspended or revoked if any false information is supplied toward securing the permit/any unauthorized changes are made to the site/any unauthorized changes are made in the installation of the system. Improvement Permit with plat valid without expiration. Improvement Permit with site plan valid for sixty months. Authorization to Construct is valid for a period equal to that of Improvement Permit – not to exceed sixty months.

Signed: X date

Installed by: D & M

Improvement Permit by: Wesley Sparks RS. date 4/15/04

Operation Permit by: Wesley Sparks RS. date 9/23/04

Authorization to Construct by: Wesley Sparks RS. date 4/15/04

Existing System Inspection by: date

HEALTH DEPT. COPY: WHITE OWNER COPY (FINAL): YELLOW OWNER COPY (INITIAL): PINK