# IREDELL COUNTY HEALTH DEPARTMENT

STATESVILLE 704-878-5305 50,00 Paid MOORESVILLE 704-664-5281

## IMPROVEMENT PERMIT / AUTHORIZATION TO CONSTRUCT / OPERATION PERMIT / EXISTING SYSTEM INSPECTION

PERMIT# 106973 PIN# ~~4636-78-4856~~ ~~4636-78-6656~~ 4636-78-6656 DATE 3/30/04

OWNER OR CONTRACTOR Wayne Walker PHONE: Business 704-361-3565 Home

ADDRESS 22113 Dalilla Dr, Charlotte, NC. 28031

LOCATION Webbed Foot / 1100 TL Linesville TR Webbed Foot on (R) before stop sign

SUBDIVISION ? HUNTINGTON HEAD BLOCK / SECTION 1 LOT 3 LOT AREA .69 SITE CLASS. PS DESIGN FLOW 480 L.T.A.R. .3

Septic Tank: 1000 Gallons; STB 821 Date

Pump Tank: Gallons; PT Date

Pump Make: Model Serial No.

Nitrification Field: No Fields 1 Square Feet 534/801 Linear Feet 267

No Lines 8@37(46) Trench Width 2-3' Max Trench Bottom Depth 3'

[X] New System [ ] Repair System Type: I, II, (III), IV, V, VI

System Description: Center Feed - 16" PRBPS

Repair System Description: Same

Maintenance Agreement Required: [ ] Yes [X] No

[X] House/Mod. Home No. Bedrooms 4

[ ] Mobile Home No. Bathrooms 3

[ ] Business No. Employees

[ ] Other

Water Supply: [ ] Individual [ ] Public [X] Community


~~Gravel Depth~~ SAND [ ] Slab [X] Crawl Space [ ] Basement w/plumbing [ ] Basement wo/plumbing

Comments/Conditions: 2' on 8' Centers - 3' on 9' Centers.

Comments/Conditions: Put this home on Lot 2 of this property.

(1" = 50')

INITIAL SITE SKETCH 160

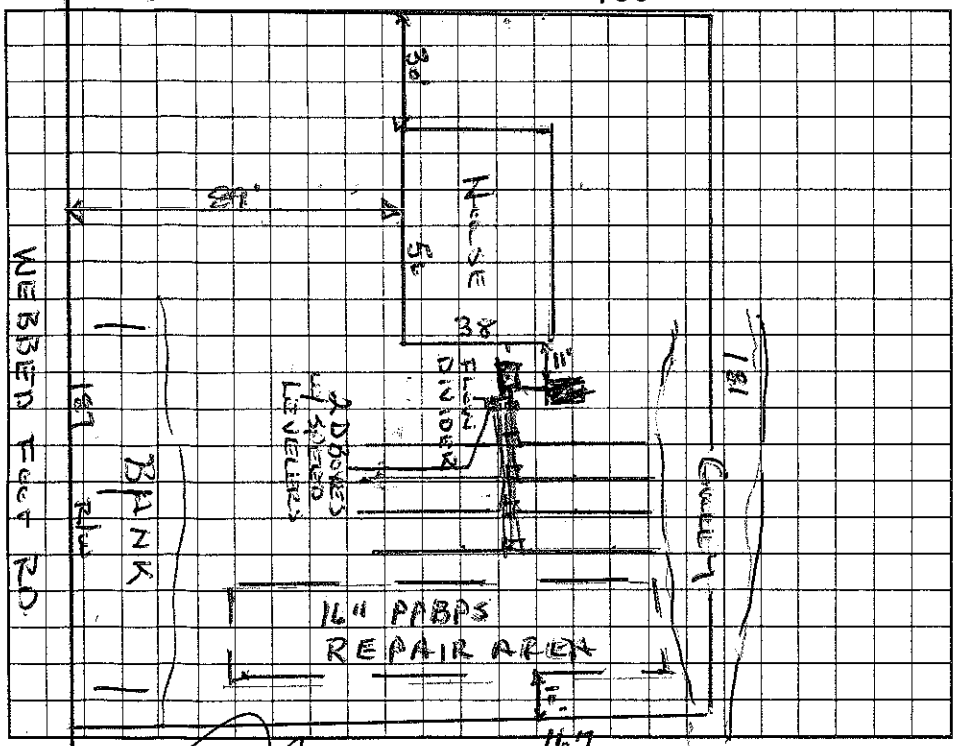


AS BUILT SKETCH

Permit can be suspended or revoked if any false information is supplied toward securing the permit/any unauthorized changes are made to the site/any unauthorized changes are made in the installation of the system. Improvement Permit with plat valid without expiration. Improvement Permit with site plan valid for sixty months. Authorization to Construct is valid for a period equal to that of Improvement Permit – not to exceed sixty months.

Signed: X date 4/2/04 Installed by: D+M Contracting

Improvement Permit by: Wesley Sparks R.S. date 3/31/04 Operation Permit by: Wesley Sparks R.S. date 8/19/05

Authorization to Construct by: Wesley Sparks R.S. date 3/31/04 Existing System Inspection by: date

HEALTH DEPT. COPY: WHITE OWNER COPY (FINAL): YELLOW OWNER COPY (INITIAL): PINK