4:00

IREDELL COUNTY HEALTH DEPARTMENT

STATESVILLE 704-878-5305 MOORESVILLE 704-664-5281

IMPROVEMENT PERMIT / CERTIFICATE OF COMPLETION / OPERATION PERMIT / EXISTING SYSTEM INSPECTION

PROPERTY DESCRIPTION NO. 24342 DATE 8/21/96 TAX MAP NO. 2K 10 A 10 Watershed: X Yes ☐ No

OWNER OR CONTRACTOR Brian Long PHONE: Business Home 892-5518

ADDRESS c/o Lake Properties 19708 Hwy 73 N Cornelius, NC 28031 4636-78-8017

LOCATION Conway Loop TR Wetland Front Qr. to 2nd lot on (R)

SUBDIVISION Mallard Head BLOCK / SECTION LOT 10 LOT AREA .45AC SITE CLASS. P3 DESIGN FLOW 360 L.T.A.R. .25

Septic Tank: 1000 Gallons; STB 794 Date 5/9/97

Pump Tank: Gallons; PT Date

Pump Make: Model Serial No.

Nitrification Field: No Fields 1 Square Feet 1440 Linear Feet X 360

No Lines 4 Trench Width 36" Max Trench Bottom Depth 30" Gravel Depth SAND.

X New System ☐ Repair System Type: I, II, III, IV, V, VI

System Description: GRAV-CH PLASTIC

Repair System Description: SAME

Maintenance Agreement Required: ☐ Yes X No

X House/Mod. Home ☐ Mobile Home ☐ Business ☐ Other

No. Bedrooms 3 No. Bathrooms 2.5 No. Employees


☐ Slab X Crawl Space ☐ Basement w/plumbing ☐ Basement wo/plumbing

Water Supply: ☐ Individual ☐ Community X Public

Comments:

Comments:

INITIAL SITE SKETCH 133' 1"=40'

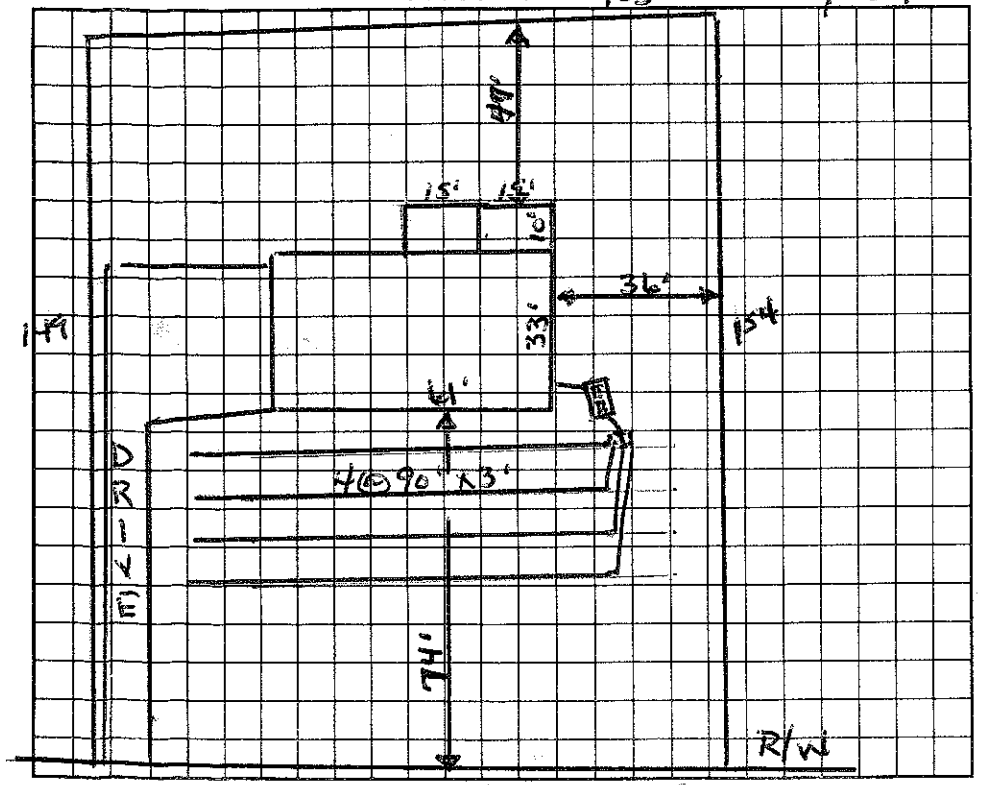

AS BUILT SKETCH

Same as Sketch

I understand that this permit can be suspended or revoked if any false information is supplied toward securing the permit/any unauthorized changes are made to the site/any unauthorized changes are made in the installation of the system.

Signed: X Brian Long Wetland Front Qr.

Installed by: FJ ERVIN

Improvement Permit by: Wesley Sparks R.S. date 8/21/96

Insect Wesley Sparks R.S. date 8/21/96

Certificate of Completion by: date

Operation Permit by: C. Rhyne Thomas date 8/25/97

INSPECTION COPY (FINAL): GREEN OWNER COPY (FINAL): YELLOW INSPECTION COPY (INITIAL): PINK OWNER COPY (INITIAL): GOLD