IREDELL COUNTY HEALTH DEPARTMENT


ENVIRONMENTAL HEALTH DIVISION

PAGE 2: *SITE PLAN WORKSHEET*

SEE THE "SAMPLE SITE PLAN" BELOW. *INCOMPLETE SITE PLANS WILL BE RETURNED TO YOU FOR COMPLETION AND MAY RESULT IN A DELAY IN THE ISSUANCE OF YOUR SEPTIC SYSTEM PERMIT!!!*

Place an (X) beside each item as you complete the site plan:

( ) Property Line measurements are clearly identified
( ) All proposed structures are indicated
( ) Front and side setbacks from property line
( ) Preferred driveway location and well location
( ) Area you prefer your septic system to be placed
( ) North arrow, or other sufficient indicator of direction

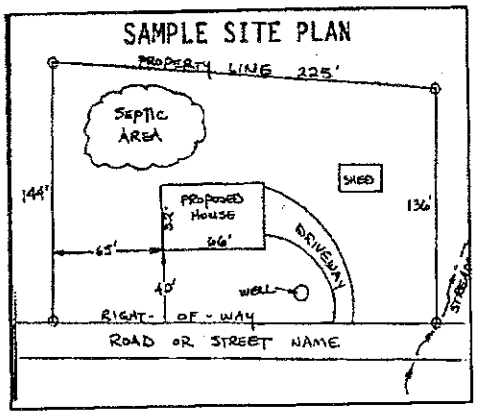


Circle N/A on the following if appropriate:

Location of septic systems and wells within 100' of your property	N/A
Location of easements and rights of ways on your property	N/A
Location of any designated wetlands on the property	N/A

USE THIS SPACE TO DRAW YOUR SITE PLAN

Show: proposed house or business footprint, wells, water lines, patios, pools and decks, and any other item that will occupy space on the site

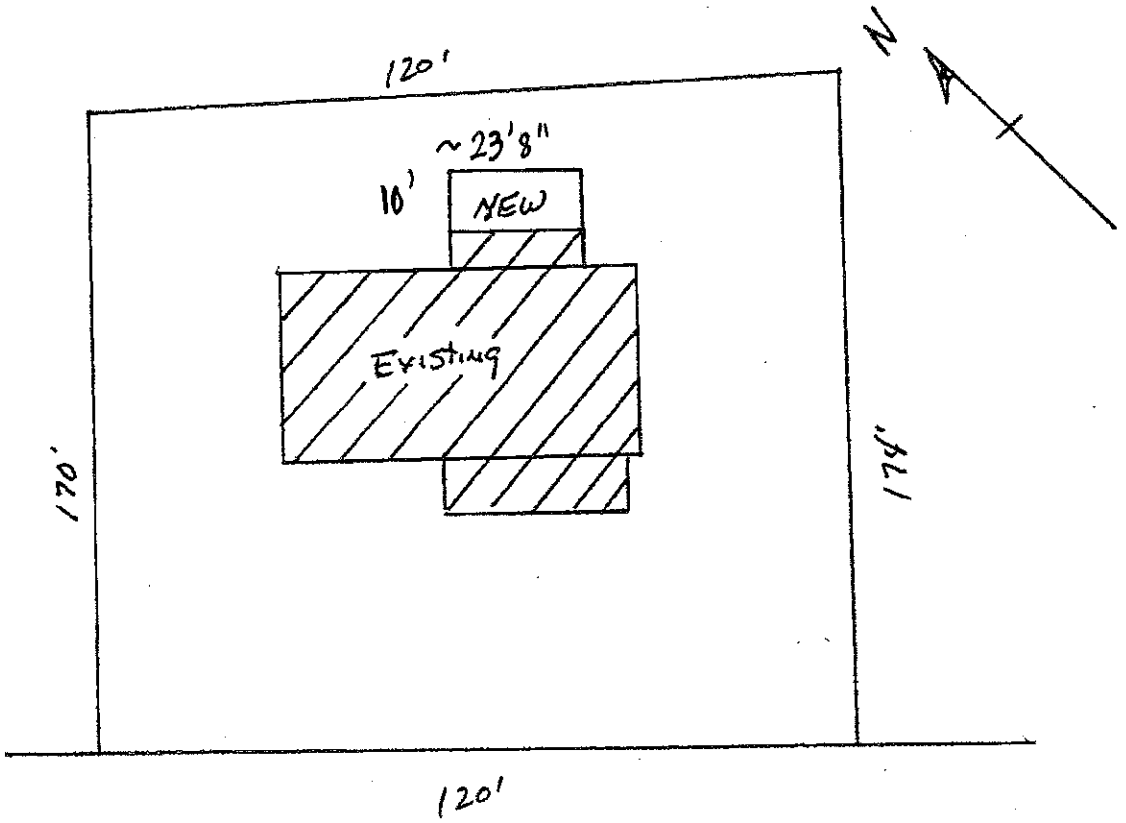

WEBBED FOOT ROAD

Signature: [signature] 9/8/15

Property owner or owner's legal representative signature (SIGNATURE REQUIRED) DATE

IREDELL COUNTY HEALTH DEPARTMENT

STATESVILLE 704-878-5305 MOORESVILLE 704-664-5281

IMPROVEMENT PERMIT / AUTHORIZATION TO CONSTRUCT / OPERATION PERMIT / EXISTING SYSTEM INSPECTION

PERMIT# 79547 PIN# 4636788456 DATE 3/19/99

OWNER OR CONTRACTOR MICHAEL BARRON PHONE: Business _____ Home 896-5819

ADDRESS 12006 SAM FOX RD. HUNTERSVILLE NC 28078

LOCATION BRAWLEY SCHOOL - TL CANVASBACK - TR WEBBED FOOT - 4TH ON RT

SUBDIVISION MALLARD HEAD BLOCK / SECTION _____ LOT 4 LOT AREA .47AC SITE CLASS PS DESIGN FLOW 360 L.T.A.R. .8

Septic Tank: 1000 Gallons; STB 312 Date 9-3-00
Pump Tank: 1000 Gallons; PT 283 Date 9-4-00
Pump Make: MYERS Model _____ Serial No. _____
Nitrification Field: No Fields 1 Square Feet 900 Linear Feet 200
No Lines 4@50' Trench Width 24" Max Trench Bottom Depth 36" Gravel Depth 2/4

☒ New System ☐ Repair System Type: I, II, III, IV, V, VI
System Description: PUMP PANEL
Repair System Description: SAME
Maintenance Agreement Required: ☐ Yes ☒ No

☒ House/Mod. Home No. Bedrooms 3
☐ Mobile Home No. Bathrooms 2½
☐ Business No. Employees _____
☐ Other _____

☐ Slab ☐ Crawl Space ☒ Basement w/plumbing ☐ Basement wo/plumbing


Water Supply: ☒ Individual ☐ Public ☒ Community

Comments/Conditions: KEEP SYSTEM 15' SIDE SLOPE FROM BASEMENT WALL.

Comments/Conditions: Riser installed

Upper ditch box fall towards house - therefore not installed in street side. DLH

INITIAL SITE SKETCH 1"=40'

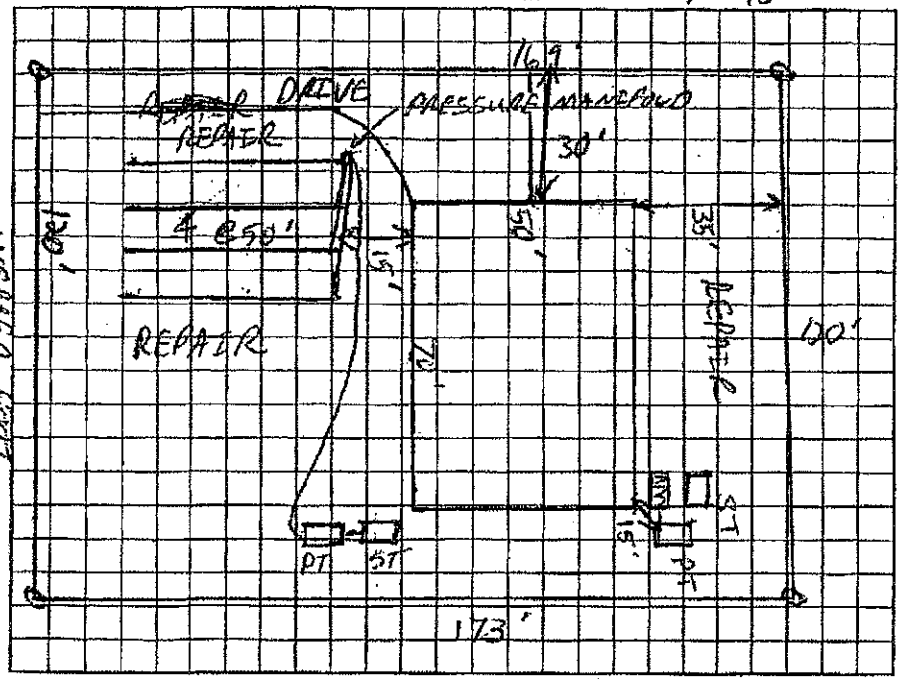

AS BUILT SKETCH

Permit can be suspended or revoked if any false information is supplied toward securing the permit/any unauthorized changes are made to the site/any unauthorized changes are made in the installation of the system. Improvement Permit with plat valid without expiration. Improvement Permit with site plan valid for sixty months. Authorization to Construct is valid for a period equal to that of Improvement Permit – not to exceed sixty months.

Signed: _____ date 4/9/99 Installed by: Michael Barron

Improvement Permit by: _____ RS date 3/19/99 Operation Permit by: _____ RS date 12/1/00

Authorization to Construct by: _____ RS date 3/19/99 Existing System Inspection by: _____ date _____

HEALTH DEPT. COPY: WHITE OWNER COPY (FINAL): YELLOW OWNER COPY (INITIAL): PINK