IREDELL COUNTY HEALTH DEPARTMENT

STATESVILLE 704-878-5305 MOORESVILLE 704-664-5281

IMPROVEMENT PERMIT / CERTIFICATE OF COMPLETION / OPERATION PERMIT / EXISTING SYSTEM INSPECTION

PROPERTY DESCRIPTION NO. 21617 DATE July 24 1995 TAX MAP NO. 2K 10 B10 Watershed: ☑ Yes ☐ No

OWNER OR CONTRACTOR Gary Poteat PHONE: Business 463-6-18-9904 Home

ADDRESS PO Box 1322, Davidson

LOCATION Brawley School Road TL Cannastock TR Fantasy Jane at end

SUBDIVISION Josh Acres BLOCK / SECTION LOT 10 LOT AREA 1.19Ac SITE CLASS. PSpa1996 DESIGN FLOW 480 gpd L.T.A.R. .3

Septic Tank 1000 Gallons; STB 794 Date 6.22.96

Pump Tank: Gallons; PT Date

Pump Make: Model Serial No.

Nitrification Field: No Fields 1 Square Feet 1200 Linear Feet 400

No Lines 4@100' Trench Width 36" Max Trench Bottom Depth 36" Gravel Depth NA

☑ New System ☐ Repair System Type: I, II, III, IV, V, VI

System Description: gravity Infiltrator

Repair System Description: Grav PPBPS

Maintenance Agreement Required: ☐ Yes ☑ No

☑ House/Mod. Home No. Bedrooms 4

☐ Mobile Home No. Bathrooms 2.5

☐ Business No. Employees

☐ Other


☐ Slab ☑ Crawl Space ☐ Basement w/plumbing ☐ Basement wo/plumbing

Water Supply: ☑ Individual ☐ Community ☐ Public

Comments:

Comments:

INITIAL SITE SKETCH

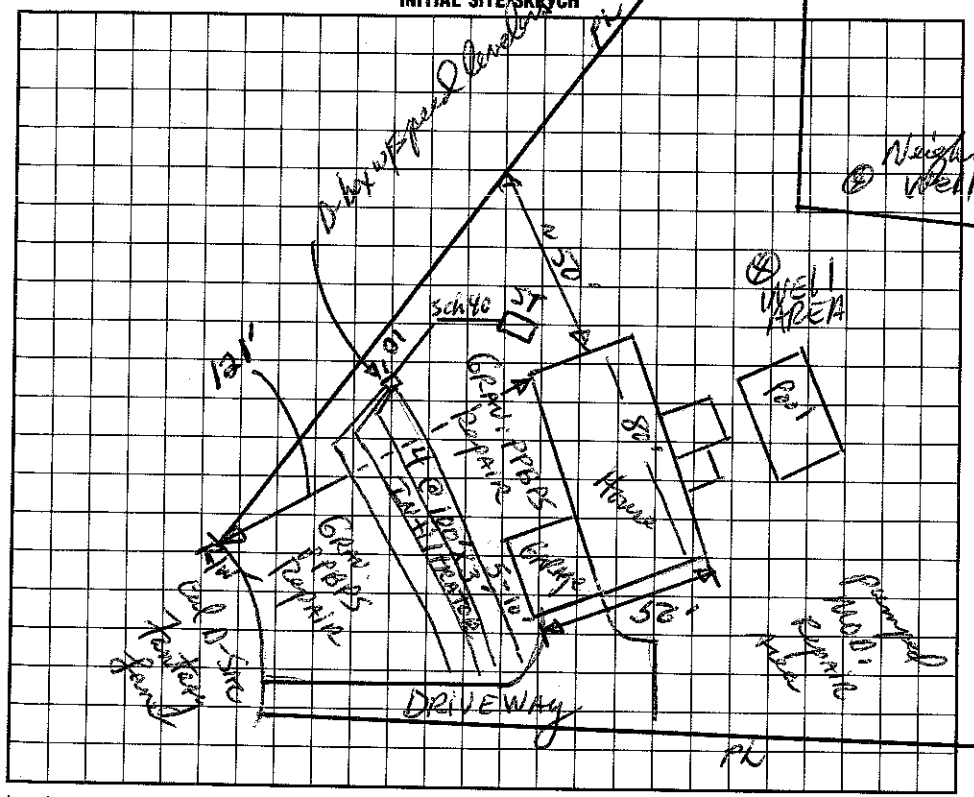

AS BUILT SKETCH

I understand that this permit can be suspended or revoked if any false information is supplied toward securing the permit/any unauthorized changes are made to the site/any unauthorized changes are made in the installation of the system. Improvement Permit is valid for 60 months from date of issuance.

Signed: Mary Glenn Poteat

Improvement Permit by: [signature], RS date 7-24-95

Existing System Inspection by: date

Installed by: Ray Beam

Certificate of Completion by: date

Operation Permit by: Wesley Sparks RS. date 8/30/96

HEALTH DEPT. COPY: WHITE INSPECTION COPY (FINAL): GREEN OWNER COPY (FINAL): YELLOW INSPECTION COPY (INITIAL): PINK OWNER COPY (INITIAL): GOLD