Gordon Oakley

IREDELL COUNTY HEALTH DEPARTMENT STATESVILLE 704-878-5305 MOORESVILLE 704-664-5281

IMPROVEMENT PERMIT / AUTHORIZATION TO CONSTRUCT / OPERATION PERMIT / EXISTING SYSTEM INSPECTION

PERMIT # 15876 PIN # 4636794510 DATE 9-2-09

OWNER or APPLICANT Shelly Southard PHONE: Business Home: 704664-7862

OWNER or APPLICANT ADDRESS 223 Commodore Ct Mooresville, NC 28117

LOCATION / DIRECTIONS Brawley School TL Shetts TL Commodore Cp on left #245

SUBDIVISION Commodore Peninsula BLOCK / SECTION LOT # 58 & Part of 59 LOT AREA .34 DESIGN FLOW 360 L.T.A.R.

Septic Tank Exist Gallons: STS Date

Pump Tank Gallons: P T Date

Pump Make Model Serial #

Nitrification Field No Fields No Lines Linear Feet

Trench Width Min Required System Depth Gravel Depth

☐ New System ☐ Repair ☐ Expansion System Type I II III IV V VI

System Description: 1149 Gravity Conv

Repair System Description: Same

Maintenance Agreement Required ☐ YES ☒ NO

☐ GRAVITY ☐ PRESSURE

☒ Residence No. Bedrooms 3

☐ Business No. Persons

☐ Other No. Employees


☐ Slab ☐ Crawl Space

☐ Basement w/plumbing ☐ Basement w/o plumbing

Water Supply: ☐ Private ☐ Public ☐ Community

Comments / Conditions

Comments / Conditions

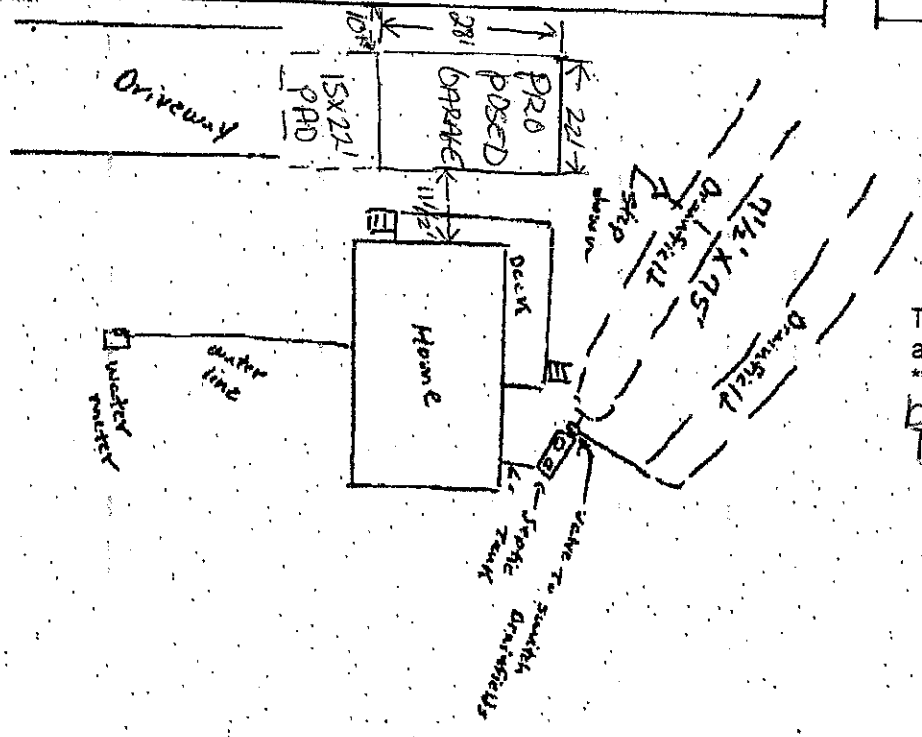

AS BUILT SKETCH

The proposed / existing Garage / Parking Pad addition does not appear to impact the existing septic system.

**NOTE: Garage Must not extend further back than Deck

Marian H. Oakley REHS

Date: 8/17/2010

ICHD-Environmental Health Division

Permit can be suspended or revoked if any false information is supplied toward securing the permit / any unauthorized changes are made to the site / any unauthorized changes are made in the installation of the system.

☐ *IMPROVEMENT PERMIT w/plat valid without expiration.* ☐ *IMPROVEMENT PERMIT w / site plan valid for 60 mos.* ☐ *AUTHORIZATION TO CONSTRUCT valid for period equal to IMPROVEMENT PERMIT-not to exceed 60 mo.*

Owner / Applicant Signature: Shelly Southard Date 9-2-09

Improvement Permit by: Marian H. Oakley RS Date 9/2/2009

Authorization to Construct by: Marian H. Oakley RS Date 9/2/2009

Installed by:

Operation Permit by: Date:

Existing System Inspected by: Marian H. Oakley RS Date: 9/2/2009

YOU SHOULD CONTACT A LOCATOR SERVICE PRIOR TO ANY EXCAVATION.

WHITE COPY Environmental Health YELLOW COPY (Final) Owner / Applicant PINK COPY (Initial) Owner / Applicant

p.1 7046600121 May 19 10 10:36p Thelma Currence