PAGE 04
06/05/2009 15:16 7046623239

IREDELL COUNTY HEALTH DEPARTMENT

Statesville Phone TR 3-7271 Mooresville Phone No. 664-5281

PERMIT TO INSTALL SEPTIC TANK

Permit No. 130 Permit Date 6-15-1973

Owner mrs. Penny Address Charlotte

Installed By E.J. Erwin Address mooresville

Location of Property 1100 TL on 1112

Commodore Penn left after water


Tank Stay left ½ to ½ mi lots 5&57

Tank		Capacity		Length of Lines		Fixtures	
Block	( )	1000	( )	225'	(✓)	No. of Baths	(2)
Precast	(✓)	1250	(✓)	250'	( )	Dishwasher	(no)
		1500	( )	Other		Garbage Grdr.	(no)
		Other				Other Washing Machine	

NOTIFY HEALTH DEPARTMENT AT LEAST EIGHT HOURS BEFORE TANK IS TO BE INSPECTED.

Final Inspection 6-15-1973 Approved (✓) Disapproved ( )

Remarks Community water System

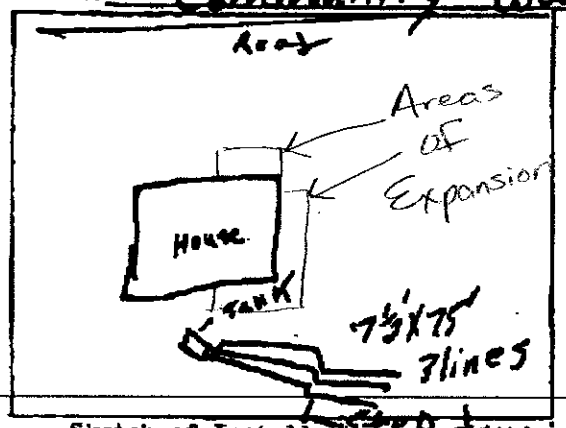

Sketch of Installation

F.C. Moore
Sanitarian