IREDELL COUNTY HEALTH DEPARTMENT

STATESVILLE 704-878-5305 MOORESVILLE 704-664-5281

IMPROVEMENT PERMIT / AUTHORIZATION TO CONSTRUCT / OPERATION PERMIT / EXISTING SYSTEM INSPECTION

PERMIT# 133986 PIN# 4636 81 7988 DATE 3-17-06

OWNER OR APPLICANT Gabriel Vargo PHONE: Business 828-267-2800 Home

ADDRESS 4509 18th St. LN. NE Hickory NC 28601

LOCATION Brawley School Rd TL Canvasback on left across from Kelly Cove Ct

SUBDIVISION Woodland Hills BLOCK / SECTION 3 LOT 37 LOT AREA .524 Ac SITE CLASS. PS DESIGN FLOW 480gpd L.T.A.R. .25gpd/ft², .3 repair

Septic Tank: 1000 Gallons; STB 101W Date 10/10/06

Pump Tank: Gallons; PT Date

Pump Make: Model Serial No.

Nitrification Field: No Fields 1 Square Feet 1920 Linear Feet 480

No Lines 5 Trench Width 36" Max Trench Bottom Depth 36" Gravel Depth N/A ☑ Gravity ☐ Pressure

☒ New System ☐ Repair ☐ Expansion System Type: I II III IV V VI

System Description: 25% reduction, gravity

Repair System Description: 2P Panel

Maintenance Agreement Required: ☐ Yes ☒ No

☒ House/Mod. Home ☐ Mobile Home ☐ Business ☐ Other

No. Bedrooms 4 No. Persons No. Employees

Water Supply: ☐ Individual ☐ Public ☒ Community


☐ Slab ☒ Crawl Space ☐ Basement w/plumbing ☐ Basement wo/plumbing

Comments:/Conditions: Keep water line 10' from septic system
Use effluent flow splitter such as Zoeller, Remove surface fill before installing system


Comments:/Conditions:
Applicant will ensure that water line will be installed w/in 1' of property line

1" = 50'

INITIAL SITE SKETCH

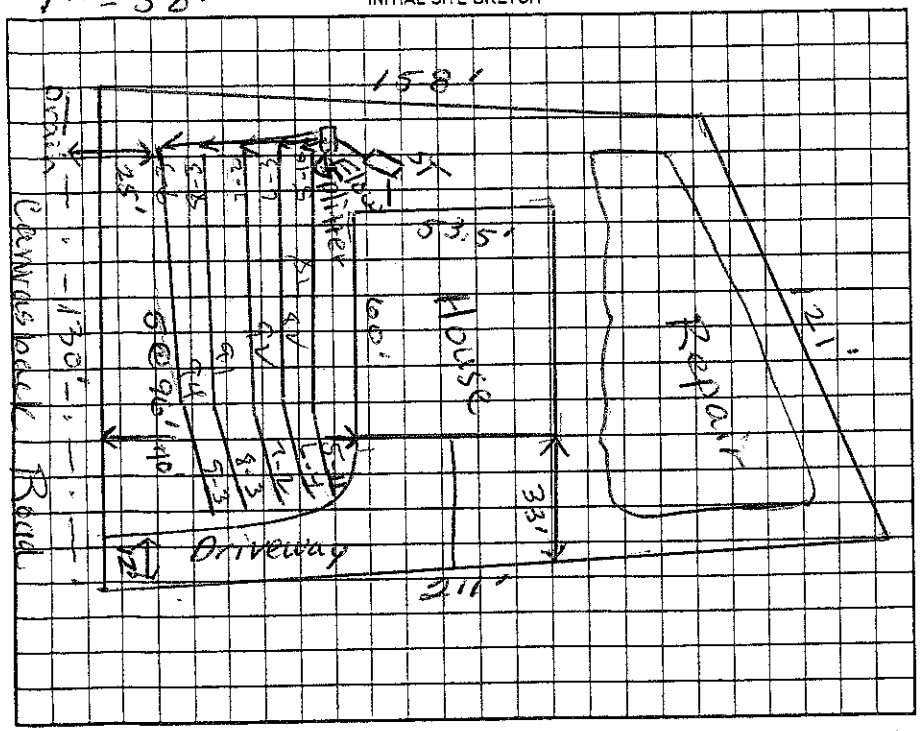

AS BUILT SKETCH

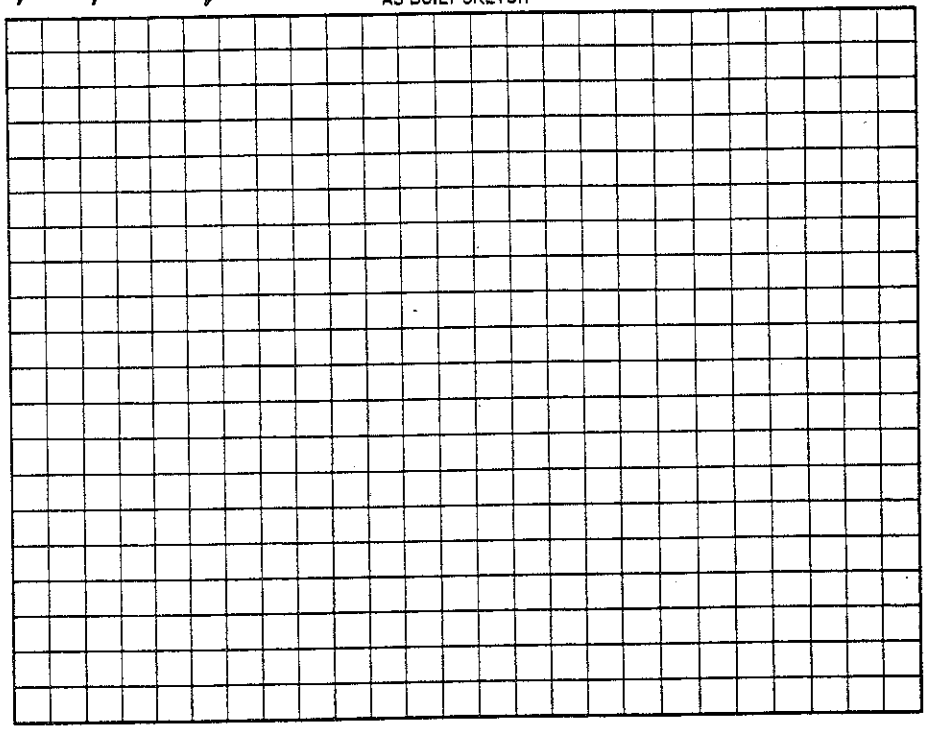

Permit can be suspended or revoked if any false information is supplied toward securing the permit/any unauthorized changes are made to the site/any unauthorized changes are made in the installation of the system. Improvement Authorization to Construct is valid for a period equal to that of Improvement Permit – not to exceed sixty months.

with plat valid without expiration ☐ Improvement Permit with site plan valid for sixty months ☒

Permit by: [signature] date 3/27/06

Construct by: Judy Merrill date 3-17-06

Installed by: Tommy Fryer

Operation Permit by: Wesley Sparks R.S. date 11/22/06

Existing System Inspection by: date

HEALTH DEPT. COPY: WHITE OWNER COPY (FINAL): YELLOW OWNER COPY (INITIAL): PINK