IREDELL COUNTY HEALTH DEPARTMENT

STATESVILLE 704-878-5305 ☒ MOORESVILLE 704-664-5281

IMPROVEMENT PERMIT / AUTHORIZATION TO CONSTRUCT / OPERATION PERMIT / EXISTING SYSTEM INSPECTION

PERMIT # 173470 PIN # 4636 81 7988 DATE June 27, 2012

OWNER or APPLICANT Paul Barresi PHONE: Business Home: 631-495-0330

OWNER or APPLICANT ADDRESS 485 Canvasback Rd Mooresville 28117

LOCATION / DIRECTIONS Brawley School Rd TL Canvasback on left across from Kelly Cove Ct.

SUBDIVISION Woodland Hills BLOCK / SECTION 3 LOT # 37 LOT AREA .524 Ac DESIGN FLOW 480 gpd L.T.A.R.

Septic Tank Existing Gallons: STB Date

Pump Tank Gallons: P T Date

Pump Make Model Serial #

Nitrification Field No Fields No Lines Linear Feet

Trench Width Existing Max. Trench Bottom Depth Gravel Depth

☐ New System ☐ Repair ☐ Expansion System Type I II III IV V VI

System Description: 25% Reduction

Repair System Description: LP Panel

Maintenance Agreement Required ☐ YES ☒ NO

☒ GRAVITY ☐ PRESSURE

☒ Residence No. Bedrooms 4

☐ Business No. Persons

☐ Other No. Employees

☐ Slab ☒ Crawl Space

☐ Basement w/plumbing ☐ Basement w/o plumbing

Water Supply: ☐ Private ☐ Public ☒ Community

Comments / Conditions


Comments / Conditions

Plan per Jacobs On-Site Development

INITIAL SITE SKETCH

Do not cut within 15' sideslope of repair lines

AS BUILT SKETCH

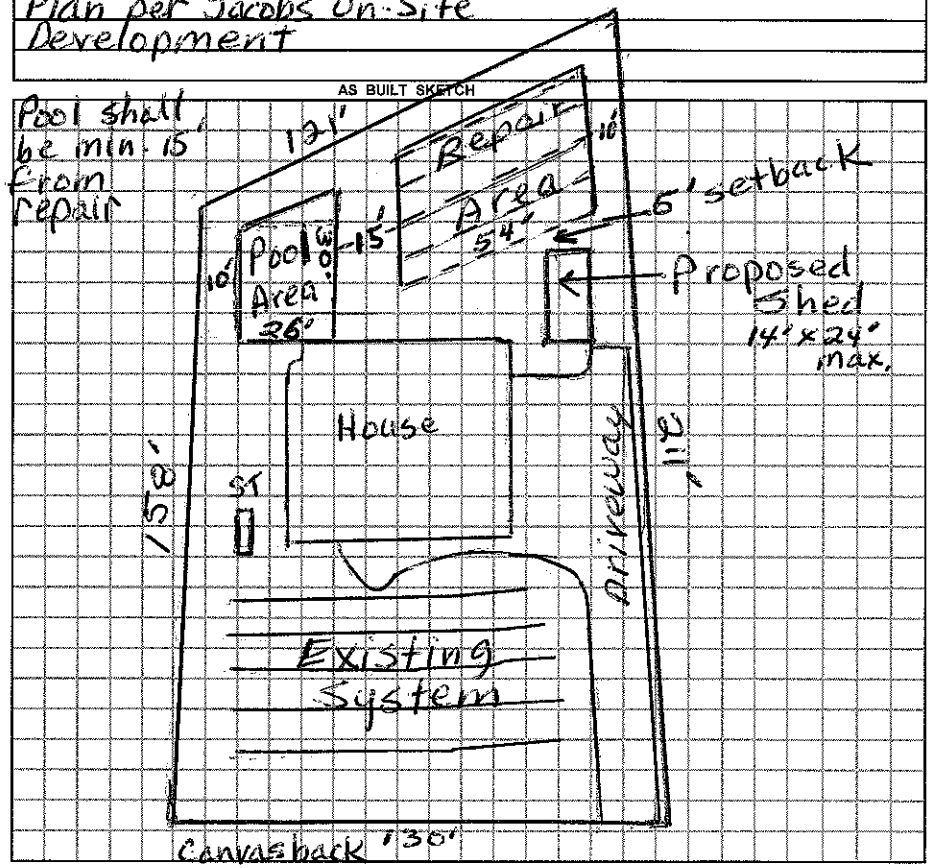

Permit can be suspended or revoked if any false information is supplied toward securing the permit / any unauthorized changes are made to the site / any unauthorized changes are made in the installation of the system.

☐ *IMPROVEMENT PERMIT w / site plan valid without expiration.* ☒ *IMPROVEMENT PERMIT w / site plan valid for 60 mos.* ☐ *AUTHORIZATION TO CONSTRUCT valid for period equal to IMPROVEMENT PERMIT-not to exceed 60 mo.*

Owner / Applicant Signature: Date 6/28/12

Improvement Permit by: Date

Authorzation to Construct by: Date

YOU SHOULD CONTACT A LOCATOR SERVICE PRIOR TO ANY EXCAVATION.

Installed by:

Operation Permit by: Date:

Existing System Inspected by: Judy Melville Date: 6-28-12

WHITE COPY Environmental Health YELLOW COPY (Final) Owner / Applicant PINK COPY (Initial) Owner / Applicant