4636819299

IREDELL COUNTY HEALTH DEPARTMENT

STATESVILLE 704-878-5305 MOORESVILLE 704-664-5281

IMPROVEMENT PERMIT / CERTIFICATE OF COMPLETION / OPERATION PERMIT / EXISTING SYSTEM INSPECTION

PROPERTY DESCRIPTION NO. 18547 DATE June 8, '94 TAX MAP NO. 2G 24 B5 Watershed: ☒ Yes ☐ No

OWNER OR CONTRACTOR Charles Donaldson PHONE: Business ______ Home 892-8578 LN

ADDRESS PO Box 95, Mt. Mourne

LOCATION 1100 TL 1179 to end on Right

SUBDIVISION Donaldson Landing BLOCK / SECTION 2 LOT 35 LOT AREA 19945 ft² SITE CLASS PS pro PS DESIGN FLOW 360 gpd L.T.A.R. .3

Septic Tank: 1000 Gallons; STB 794 Date 1/4/95
Pump Tank: ______ Gallons; PT ______ Date ______
Pump Make: ______ Model ______ Serial No. ______
Nitrification Field: No Fields 1 Square Feet ______ Linear Feet 200
No Lines @ 4 Trench Width 24" Max Trench Bottom Depth 36" Gravel Depth NA

☒ New System ☐ Repair System Type: I, II, (III), IV, V, VI
System Description: gravity PPBPS
Repair System Description: LP PPBPS
Maintenance Agreement Required: ☐ Yes ☒ No

☒ House/Mod. Home No. Bedrooms 3
☐ Mobile Home No. Bathrooms 2½
☐ Business No. Employees ______
☐ Other ______


☐ Slab ☒ Crawl Space ☐ Basement w/plumbing ☐ Basement wo/plumbing

Water Supply:
☐ Individual
☒ Community
☐ Public

Comments: Exit plumbing at grade in order to accomodate specified tank bottom depth. Install system exactly as shown regarding setback distances.

Comments: 2-30', 2-70'

INITIAL SITE SKETCH

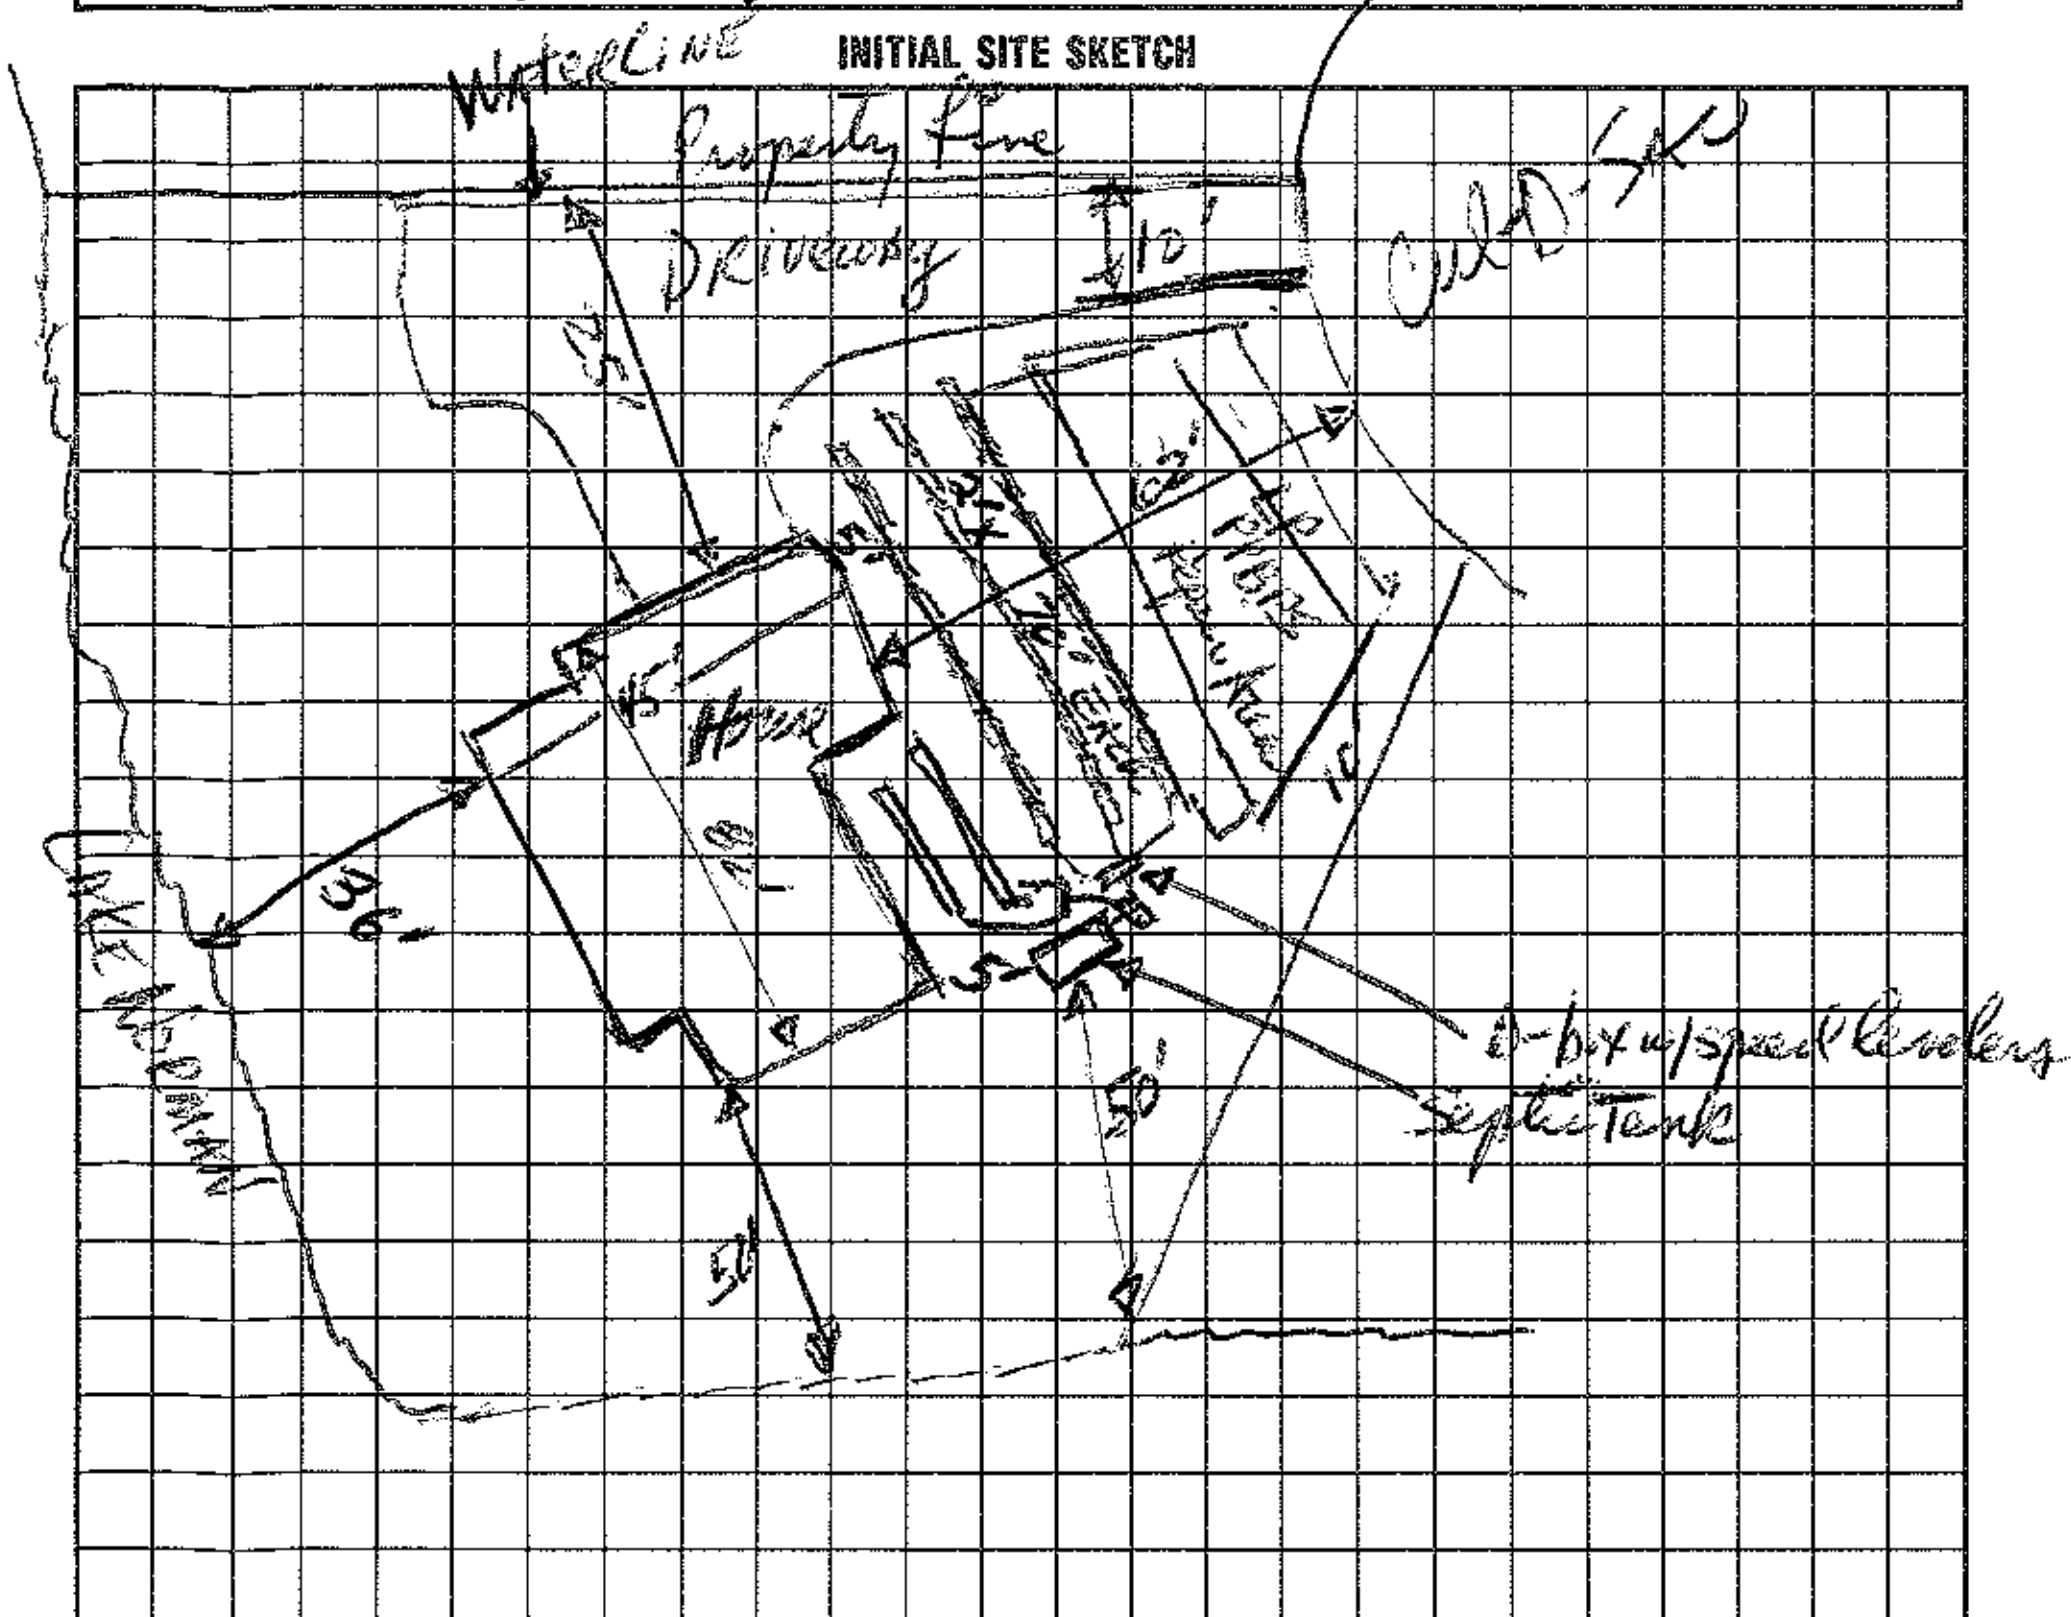

AS BUILT SKETCH

I understand that this permit can be suspended or revoked if any false information is supplied toward securing the permit/any unauthorized changes are made to the site/any unauthorized changes are made in the installation of the system. Improvement Permit is valid for 60 months from date of issuance.

Signed: X [signature]

Improvement Permit by: [signature], RS date 6/8/94

Existing System Inspection by: ______ date ______

Installed by: F J Ervin

Certificate of Completion by: Wesley Sparks RS date 1/6/95

Operation Permit by: ______ date ______

HEALTH DEPT. COPY: WHITE INSPECTION COPY (FINAL): GREEN OWNER COPY (FINAL): YELLOW INSPECTION COPY (INITIAL): PINK OWNER COPY (INITIAL): GOLD