IREDELL COUNTY HEALTH DEPARTMENT

Authorization to Construct 4636826445

STATESVILLE 704-878-5305 MOORESVILLE 704-664-5281

IMPROVEMENT PERMIT / ~~CERTIFICATE OF COMPLETION~~ / OPERATION PERMIT / EXISTING SYSTEM INSPECTION

PROPERTY DESCRIPTION NO. 24074 DATE 6/13/96 TAX MAP NO. 2G 19 A 41 Watershed: ☐ Yes ☒ No

OWNER OR CONTRACTOR Woodmasters MSM PHONE: Business 663-5592 Home

ADDRESS PO Box 1738 Mooresville, NC. 28115

LOCATION Brawley Sch Tr Canvasback, 2ND lot on (R) past Canvasback intersection

SUBDIVISION Woodland Hills BLOCK / SECTION 3 LOT 41 LOT AREA .45 AC SITE CLASS P5 DESIGN FLOW 360 L.T.A.R. .3

Septic Tank: 1000 Gallons; STB 794 Date 10/11/96

Pump Tank: ____ Gallons; PT ____ Date ____

Pump Make: ____ Model ____ Serial No. ____

Nitrification Field: No Fields 1 Square Feet 1200 Linear Feet 300 ~~450~~

No Lines 5 Trench Width 36" Max Trench Bottom Depth 32" Gravel Depth SAND.

☒ New System ☐ Repair System Type: I, II, (III), IV, V, VI

System Description: Ch PLASTIC

Repair System Description: SAME

Maintenance Agreement Required: ☐ Yes ☒ No

☒ ~~House~~/Mod. Home No. Bedrooms 3

☐ Mobile Home No. Bathrooms 2

☐ Business No. Employees ____

☐ Other ____


☐ Slab ☒ Crawl Space ☐ Basement w/plumbing ☐ Basement wo/plumbing

Water Supply: ☐ Individual ☒ Community ☐ Public

Comments: Lot < 20,000 FT²
25% reduction for Ch. Plastic

Comments:

INITIAL SITE SKETCH

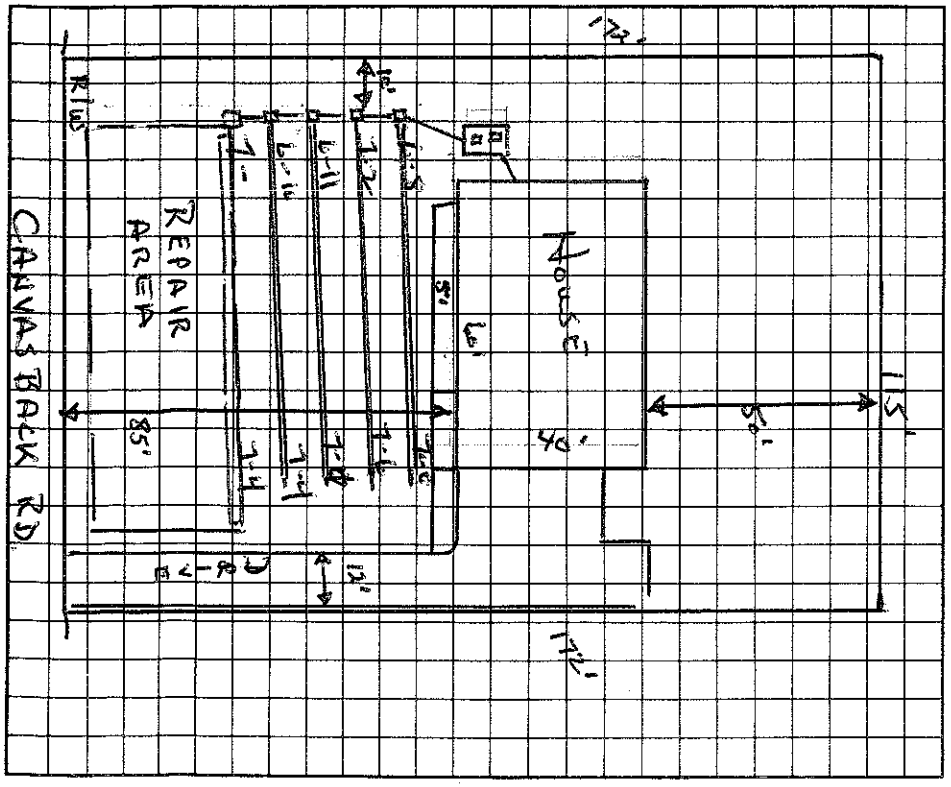

AS BUILT SKETCH

I understand that this permit can be suspended or revoked if any false information is supplied toward securing the permit/any unauthorized changes are made to the site/any unauthorized changes are made in the installation of the system.

Authorization to Construct valid for 60 months.

Signed: ☒ Cathie Campbell

Improvement Permit by: Wesley Sparks RS. date 6/13/96

Authorization to Construct by: Wesley Sparks date 6/13/96

Installed by: Lewon Benton

Certificate of Completion by: ____ date ____

Operation Permit by: Wesley Sparks RS date 12/11/96

HEALTH DEPT. COPY: WHITE INSPECTION COPY (FINAL): GREEN OWNER COPY (FINAL): YELLOW INSPECTION COPY (INITIAL): PINK OWNER COPY (INITIAL): GOLD