IREDELL COUNTY HEALTH DEPARTMENT

STATESVILLE 704-878-5305 MOORESVILLE 704-664-5281

IMPROVEMENT PERMIT / AUTHORIZATION TO CONSTRUCT / OPERATION PERMIT / EXISTING SYSTEM INSPECTION

PERMIT# 106906 PIN# 4636-82-8347 DATE 6/20/02

OWNER OR CONTRACTOR Vasile - Lazar PHONE: Business 704-799-0645 Home

ADDRESS 131 Sagamore Mooresville NC 28117

LOCATION Bradley Sch, TL Canvasback, Chatworth on Rt.

SUBDIVISION Woodland Hills BLOCK / SECTION 3 LOT 23 LOT AREA SITE CLASS. PS DESIGN FLOW 360 L.T.A.R. .55

Septic Tank: 1000 Gallons; STB 1007 Date 7/10/02

Pump Tank: Gallons; PT Date

Pump Make: Model Serial No.

Nitrification Field: No Fields 1 Square Feet 1050 Linear Feet 350

No Lines 5 @ 70' Trench Width 36" Max Trench Bottom Depth 36" Gravel Depth 12"

[X] New System [ ] Repair System Type: I, (II), III, IV, V, VI

System Description: Gravity Conventional

Repair System Description: 25% Reduction

Maintenance Agreement Required: [ ] Yes [X] No

[X] House/Mod. Home No. Bedrooms 5

[ ] Mobile Home No. Bathrooms 2

[ ] Business No. Employees

[ ] Other


[ ] Slab [X] Crawl Space [ ] Basement w/plumbing [ ] Basement wo/plumbing

Water Supply: [ ] Individual [ ] Public [X] Community


Comments:/Conditions:

Comments:/Conditions:

INITIAL SITE SKETCH 1" = 50'

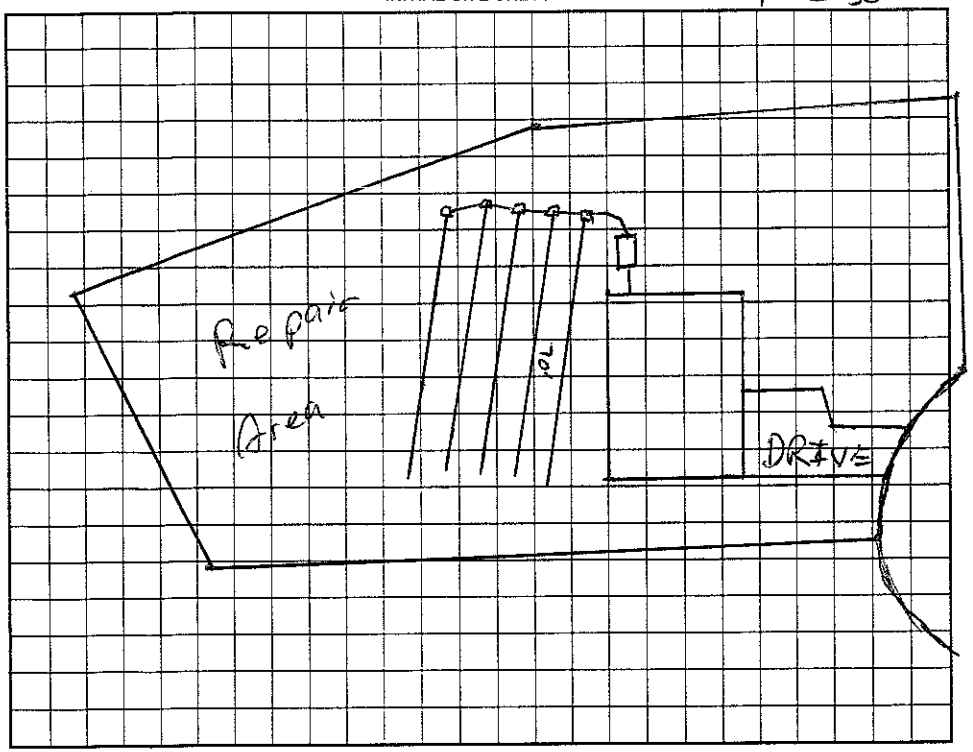

AS BUILT SKETCH

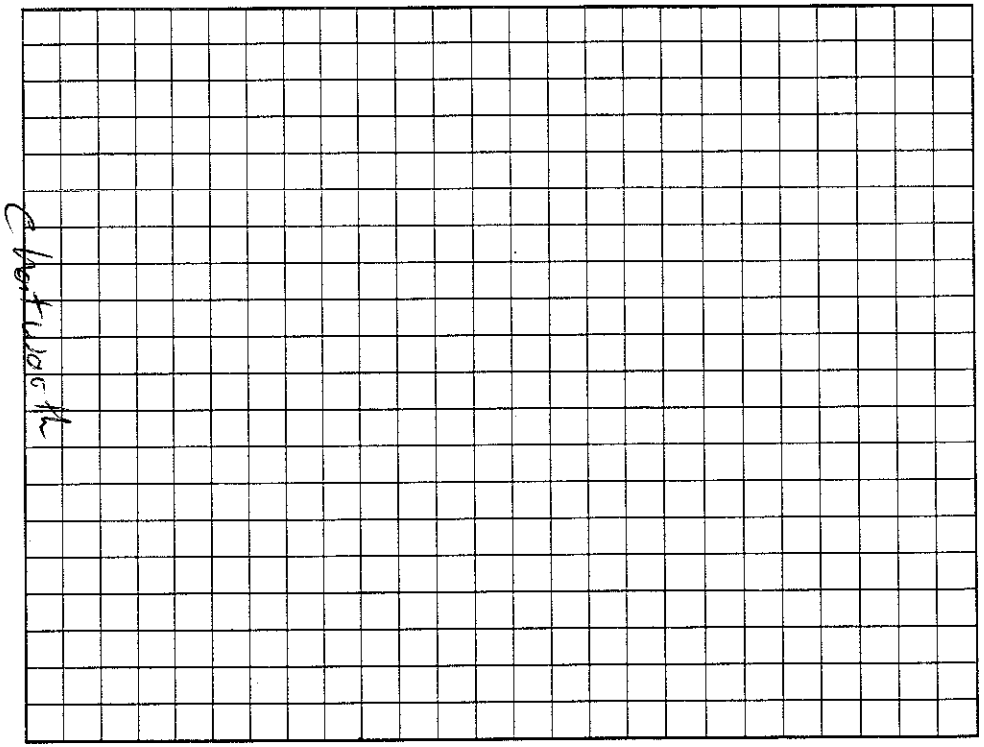

Permit can be suspended or revoked if any false information is supplied toward securing the permit/any unauthorized changes are made to the site/any unauthorized changes are made in the installation of the system. Improvement Permit with plat valid without expiration. Improvement Permit with site plan valid for sixty months. Authorization to Construct is valid for a period equal to that of Improvement Permit – not to exceed sixty months.

Signed: /s/ Le Lazar date

Installed by: Wayne Clontz

Improvement Permit by: RS date 6/20/02

Operation Permit by: RS date 9/4/02

Authorization to Construct by: RS date 6/20/02

Existing System Inspection by date

HEALTH DEPT. COPY: WHITE OWNER COPY (FINAL): YELLOW OWNER COPY (INITIAL): PINK