IREDELL COUNTY HEALTH DEPARTMENT

STATESVILLE 704-878-5305 1300.00 Paid MOORESVILLE 704-664-5281

IMPROVEMENT PERMIT / AUTHORIZATION TO CONSTRUCT / OPERATION PERMIT / EXISTING SYSTEM INSPECTION

PERMIT# 115183 PIN# 4636 83 2372 DATE 10/15/04

OWNER OR CONTRACTOR Donna Smith / Lakeside Builders PHONE: Business 704-799-9813 Home

ADDRESS 174 Ponderosa Circle Mooresville, NC. 28117

LOCATION Spring Run Dr 1100 ft Conrad Land TR Spring Run, 3 BR lot on (R)

SUBDIVISION Mallard Head BLOCK / SECTION LOT 109 LOT AREA .46 SITE CLASS PS DESIGN FLOW 360 L.T.A.R. .3

Septic Tank: 1000 Gallons; STB 312 Date 6/12/04

Pump Tank: Gallons; PT Date

Pump Make: Model Serial No.

Nitrification Field: No Fields 1 Square Feet 900 Linear Feet 300

No Lines 3 @ 100' Trench Width 3' Max Trench Bottom Depth 3' Gravel Depth No

[X] New System ☐ Repair System Type: I, II, III, IV, V, VI

System Description: GRAVITY - 25% Reduced

Repair System Description: Pressure - 16 PPBPS

Maintenance Agreement Required: ☐ Yes [X] No

[X] House/Mod. Home No. Bedrooms 3

☐ Mobile Home No. Bathrooms 3

☐ Business No. Employees

☐ Other


☐ Slab [X] Crawl Space ☐ Basement w/plumbing ☐ Basement wo/plumbing

Water Supply: ☐ Individual ☐ Public ☐ Community

Comments:/Conditions:

Comments:/Conditions:

INITIAL SITE SKETCH

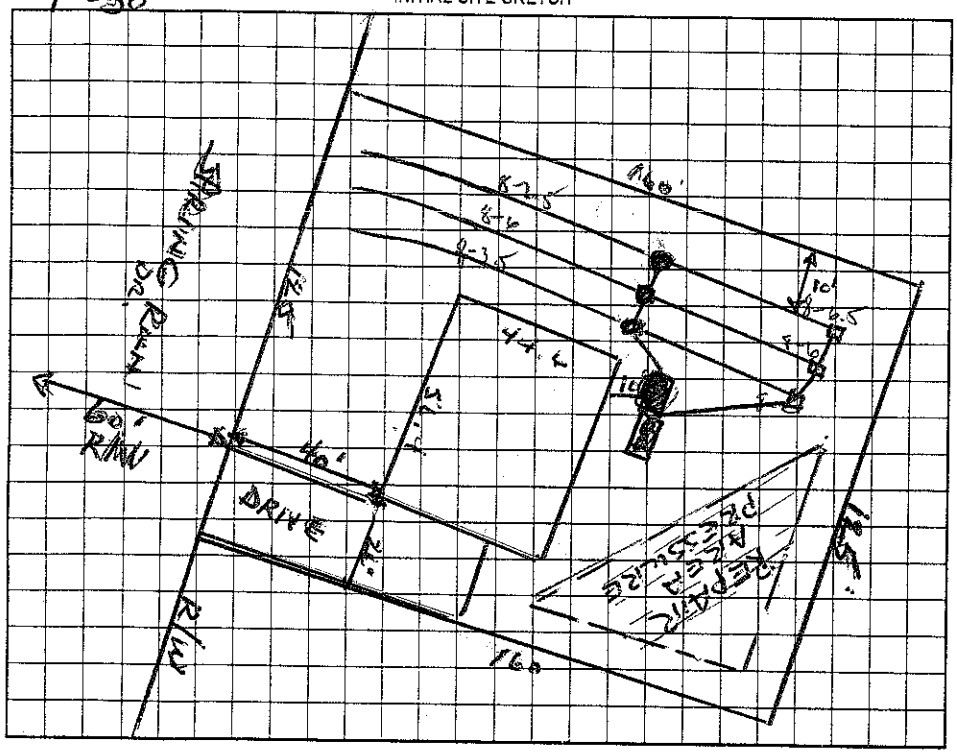

AS BUILT SKETCH

Permit can be suspended or revoked if any false information is supplied toward securing the permit/any unauthorized changes are made to the site/any unauthorized changes are made in the installation of the system. Improvement Permit with plat valid without expiration. Improvement Permit with site plan valid for sixty months. Authorization to Construct is valid for a period equal to that of Improvement Permit – not to exceed sixty months.

Signed: [signature] date 10/18/04 Installed by: Dobson & Sons.

Improvement Permit by: Wesley Sparks RS. date 10/15/04 Operation Permit by: Wesley Sparks RS. date 4/6/05

Authorization to Construct by: Wesley Sparks RS. date 10/15/04 Existing System Inspection by: date

HEALTH DEPT. COPY: WHITE OWNER COPY (FINAL): YELLOW OWNER COPY (INITIAL): PINK