IREDELL COUNTY HEALTH DEPARTMENT

STATESVILLE 704-878-5305 MOORESVILLE 704-664-5281

IMPROVEMENT PERMIT / AUTHORIZATION TO CONSTRUCT / OPERATION PERMIT / EXISTING SYSTEM INSPECTION

$ 50

PERMIT# 113957 PIN# 4636-83-3299 DATE 3/3/04

OWNER OR CONTRACTOR David Smith PHONE: Business 704-201-5260 Home

ADDRESS 174 Ponderosa Cir Mooresville NC 28117

LOCATION BSR, TL Canvasback, TR Spring Run, on Rt 1 267 Spring Run DR

SUBDIVISION Mallard Head BLOCK / SECTION LOT 108 LOT AREA 20,000 FT2 SITE CLASS. PS DESIGN FLOW 450 L.T.A.R. 0.5

Septic Tank: 1000 Gallons; STB 794 Date 2/15/04

Pump Tank: Gallons; PT Date

Pump Make: Model Serial No.

Nitrification Field: No Fields 3 Square Feet 816 Linear Feet 272

No Lines 8@34 Trench Width 24" Max Trench Bottom Depth 36" Gravel Depth —

☒ New System ☐ Repair System Type: I, II, III, IV, V, VI

System Description: Gravity Pipe/Block

Repair System Description: Saprolite (<40%)

Maintenance Agreement Required: ☐ Yes ☒ No

☒ House/Mod. Home No. Bedrooms 4

☐ Mobile Home No. Bathrooms

☐ Business No. Employees

☐ Other

☐ Slab ☒ Crawl Space ☐ Basement w/plumbing ☐ Basement wo/plumbing

Water Supply: ☐ Individual ☐ Public ☒ Community


Comments:/Conditions:

1" = 40'

Comments:/Conditions:

installed as drawn

INITIAL SITE SKETCH

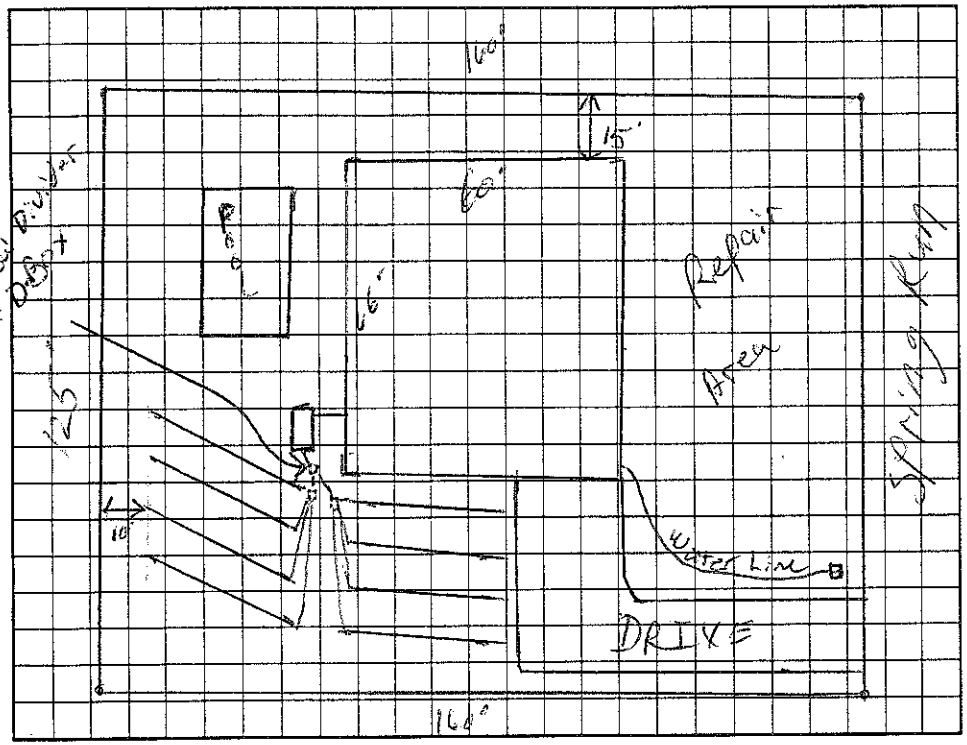

AS BUILT SKETCH

Permit can be suspended or revoked if any false information is supplied toward securing the permit/any unauthorized changes are made to the site/any unauthorized changes are made in the installation of the system. Improvement Permit ~~with plat~~ valid ~~without expiration~~. Improvement Permit with site plan valid for sixty months. Authorization to Construct is valid for a period equal to that of Improvement Permit – not to exceed sixty months.

Signed: date 3/4/04

Improvement Permit by: RS date 3/3/04

Authorization to Construct by: RS date 3/3/04

Installed by: Orbison Const.

Operation Permit by: Wesley Sparks RS. date 3/19/04

Existing System Inspection by: date

HEALTH DEPT. COPY: WHITE OWNER COPY (FINAL): YELLOW OWNER COPY (INITIAL): PINK