IREDELL COUNTY HEALTH DEPARTMENT

STATESVILLE 704-878-5305 MOORESVILLE 704-664-5281

IMPROVEMENT PERMIT / AUTHORIZATION TO CONSTRUCT / OPERATION PERMIT / EXISTING SYSTEM INSPECTION

PERMIT# 138523 PIN# 4636835000 DATE 12-15-06

OWNER OR APPLICANT Robert J Edelen PHONE: Business _____ Home 704-664-4029

ADDRESS 272 Spring Run Mooresville

LOCATION Brawley School Rd TL Canvasback on right at corner of Spring Run

SUBDIVISION Leaf-Trent BLOCK / SECTION _____ LOT 1 LOT AREA .41 Ac SITE CLASS. PS DESIGN FLOW 360gpd L.T.A.R. .3 gpd/ft²

Septic Tank: 1000 Gallons; STB 794 Date 12-22-06
Pump Tank: 1000 Gallons; PT 27 Date 4-1-07
Pump Make: Goulds Model PE5IM Serial No. _____
Nitrification Field: No Fields 1 Square Feet 1200 Linear Feet 200
No Lines 5 Trench Width 24" Max Trench Bottom Depth 36"

☒ New System ☐ Repair ☐ Expansion System Type: I II III IV V VI
System Description: LP PPBPS
Repair System Description: PPBPS
Maintenance Agreement Required: ☒ Yes ☐ No

☒ House/Mod. Home No. Bedrooms 3
☐ Mobile Home No. Persons ____
☐ Business No. Employees ____
☐ Other _____

Water Supply: ☐ Individual ☐ Public ☒ Community

Gravel Depth NA ☐ Gravity ☒ Pressure ☐ Slab ☒ Crawl Space ☐ Basement w/plumbing ☐ Basement wo/plumbing

Comments:/Conditions:


Received → 12-21-07
See attached

Comments:/Conditions:


Hold OP until receive official approval document from Duke Power for use of R/W for repair
12/12/07 Checked tanks, lines & pressure

1" = 30'

INITIAL SITE SKETCH

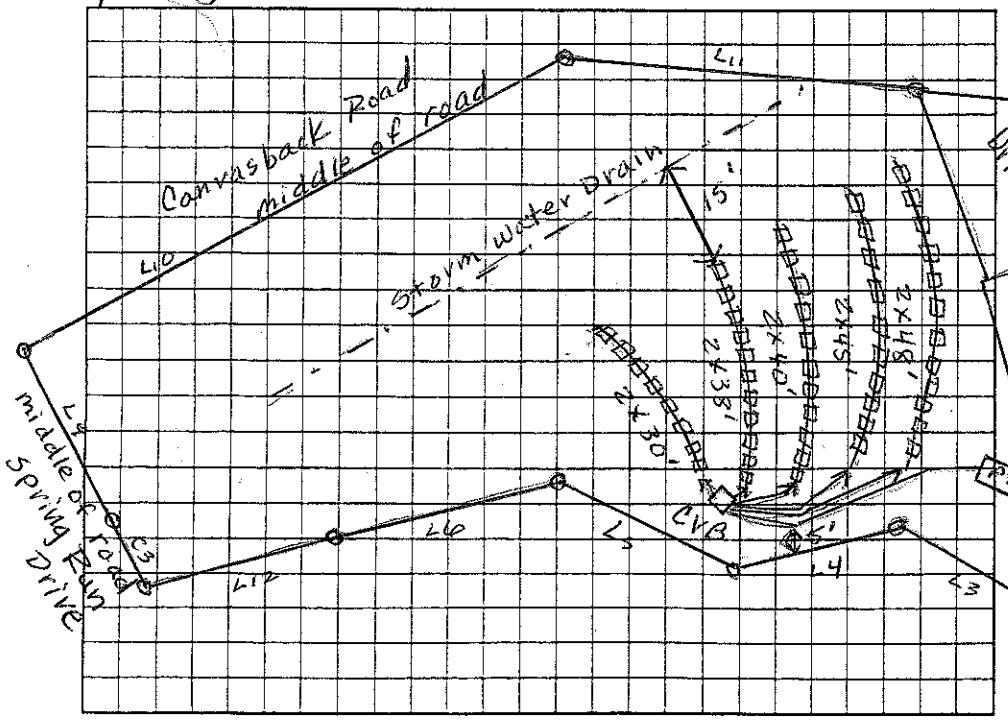

AS BUILT SKETCH

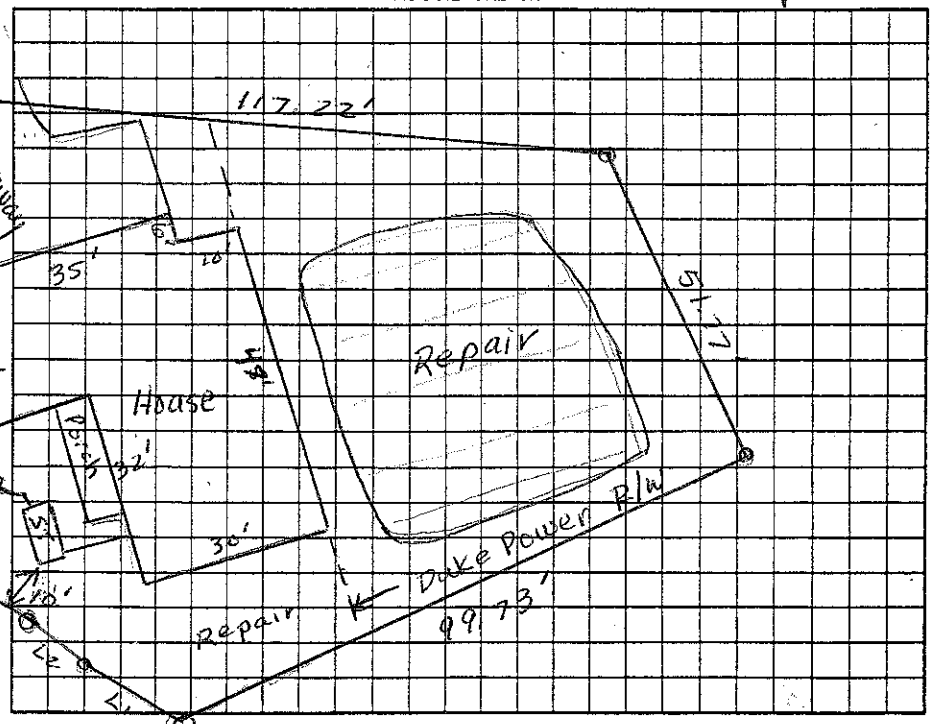

Permit can be suspended or revoked if any false information is supplied toward securing the permit/any unauthorized changes are made to the site/any unauthorized changes are made in the installation of the system. Improvement Permit with plat valid without expiration ☐ Improvement Permit with site plan valid for sixty months ☒ Authorization to Construct is valid for a period equal to that of Improvement Permit – not to exceed sixty months.

Signed: Robert J Edelen date 12-18-06 Installed by: Richard Abernathy

Improvement Permit by: Judy Melville date 12-15-06 Operation Permit by: Judy Melville date 1-2-08

Authorization to Construct by: Judy Melville date 12-18-06 Existing System Inspection by: _____ date _____

HEALTH DEPT. COPY: WHITE OWNER COPY (FINAL): YELLOW OWNER COPY (INITIAL): PINK