IREDELL COUNTY HEALTH DEPARTMENT

STATESVILLE 704-878-5305 MOORESVILLE 704-664-5281

IMPROVEMENT PERMIT / AUTHORIZATION TO CONSTRUCT / OPERATION PERMIT / EXISTING SYSTEM INSPECTION

PERMIT # 11062-DT PIN # 4636-83-5422 DATE 4-19-11

OWNER or APPLICANT JOHN & MERA COODY PHONE: Business 704-325-1100 Home: ANTHONY SULLIVAN POOLS

OWNER or APPLICANT ADDRESS 406 CANVASBACK RD MVILLE

LOCATION / DIRECTIONS BSR, TL CANVASBACK, ON R

SUBDIVISION MALLARD HEAD BLOCK / SECTION LOT # 106 LOT AREA .46AC DESIGN FLOW 480 L.T.A.R. .3

Septic Tank EX 1000 Gallons: STB Date

Pump Tank Gallons: P T Date

Pump Make Model Serial #

Nitrification Field No Fields No Lines EXIST INFO Linear Feet

Trench Width Max. Trench Bottom Depth Gravel Depth

☐ New System ☐ Repair ☐ Expansion System Type I II III IV V VI

System Description: 25%

Repair System Description: LP-50%

Maintenance Agreement Required ☐ YES ☒ NO INITIALLY

☐ GRAVITY ☐ PRESSURE

☒ Residence No. Bedrooms 4

☐ Business No. Persons

☒ Other No. Employees

☐ Slab ☒ Crawl Space

☐ Basement w/plumbing ☐ Basement w/o plumbing

Water Supply: ☒ Private ☐ Public ☐ Community

Comments / Conditions

Comments / Conditions

POOL

INITIAL SITE SKETCH

1"=40'

POOL LOCATION VERIFIED IN FIELD

NO SIGNS OF FAILURE @ TIME OF INSPECTION

CANVASBACK

135'

REPAIR

REPAIR

WELL

AS BUILT SKETCH

108'

59'

REPAIR

EX. HOUSE

R

105'

100'

58'

15'

10'

POOL AREA

50'

165'

Permit can be suspended or revoked if any false information is supplied toward securing the permit / any unauthorized changes are made to the site / any unauthorized changes are made in the installation of the system.

☐ *IMPROVEMENT PERMIT w / plat valid without expiration.* ☐ *IMPROVEMENT PERMIT w / site plan valid for 60 mos.* ☐ *AUTHORIZATION TO CONSTRUCT valid for period equal to IMPROVEMENT PERMIT-not to exceed 60 mo.*

Owner / Applicant Signature: [signature] Date 4/20/11

Improvement Permit by: Date

Authorzation to Construct by: Date

YOU SHOULD CONTACT A LOCATOR SERVICE PRIOR TO ANY EXCAVATION.

Installed by:

Operation Permit by: Date:

Existing System Inspected by: [signature] REHS Date: 4-19-11

WHITE COPY Environmental Health YELLOW COPY (Final) Owner / Applicant PINK COPY (Initial) Owner / Applicant

IREDELL COUNTY HEALTH DEPARTMENT

STATESVILLE 704-878-5305 MOORESVILLE 704-664-5281

IMPROVEMENT PERMIT / AUTHORIZATION TO CONSTRUCT / OPERATION PERMIT / EXISTING SYSTEM INSPECTION

2100

PERMIT# 14681 PIN# 4636835422

OWNER OR APPLICANT Wesley Zdrenton DATE 11-5-07

ADDRESS 120 Fantasy Ln Mooresville, NC 28117 PHONE: Business 658-5106 Home

LOCATION Brawley School Rd TL Canvasback on right before Spring Run

SUBDIVISION Mallard Head BLOCK / SECTION LOT 106 LOT AREA .48 Acre SITE CLASS PS DESIGN FLOW 480gpd L.T.A.R. .3

Septic Tank: 1000 Gallons; STB 825 Date 12-13-07

Pump Tank: Gallons; PT Date

Pump Make: Model Serial No.

Nitrification Field: No Fields 1 Square Feet 1200' Linear Feet 400'

No Lines 4 Trench Width 36" Max Trench Bottom Depth 36" Gravel Depth N/A

☒ New System ☐ Repair ☐ Expansion System Type: I (II) III IV V VI

System Description: Gravity - 25% Reduction

Repair System Description: ☒ See Note - 50% Reduction

Maintenance Agreement Required: ☐ Yes ☒ No

☒ House/Mod. Home ☐ Mobile Home ☐ Business ☐ Other

No. Bedrooms 4 No. Persons No. Employees


Water Supply: ☒ Individual ☐ Public ☐ Community

☒ Gravity ☐ Pressure ☐ Slab ☒ Crawl Space ☐ Basement w/plumbing ☐ Basement wo/plumbing

Comments/Conditions: Okay to use "drop boxes" or distribution box.

Comments/Conditions: Note: Lot deeded prior to 1983

1:50 INITIAL SITE SKETCH

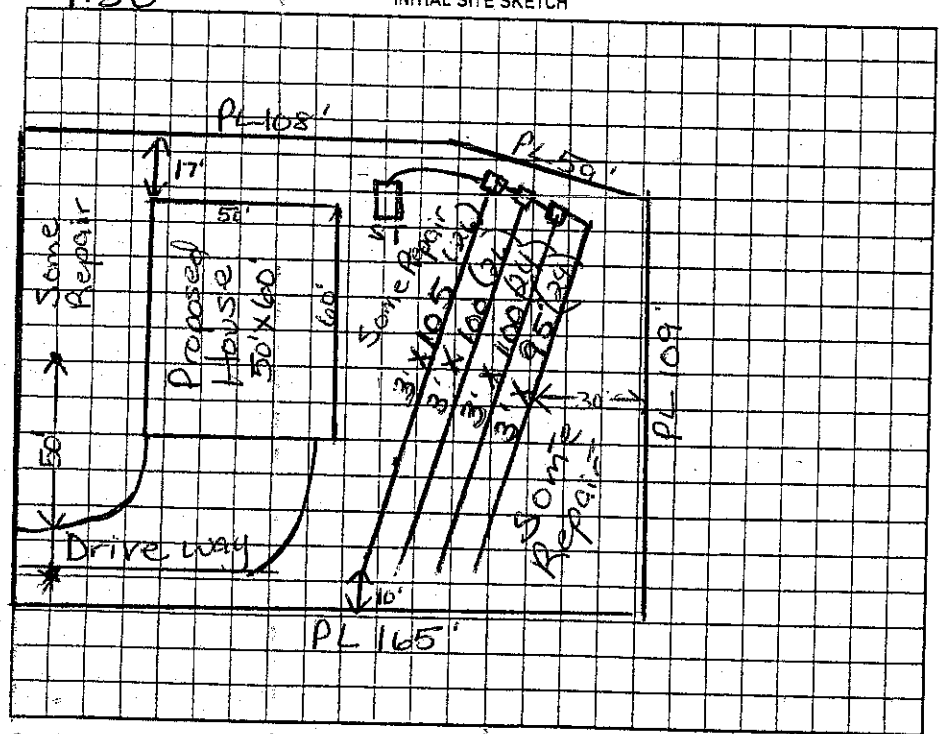

AS BUILT SKETCH

Installed Quick 4 w/ built in drop boxes as drawn

Permit can be suspended or revoked if any false information is supplied toward securing the permit/any unauthorized changes are made to the site/any unauthorized changes are made in the installation of the system. Improvement Permit with plat valid without expiration. ☐ Improvement Permit with site plan valid for sixty months ☐ Authorization to Construct is valid for a period equal to that of Improvement Permit – not to exceed sixty months.

Signed: date 11/6/07

Improvement Permit by: Maria H. Dolan RS date 11/5/07

Authorization to Construct by: Maria H. Dolan RS date 11/5/07

Installed by: Rowan Septic RS

Operation Permit by: Maria H. Dolan date 1/23/08

Existing System Inspection by: date

HEALTH DEPT. COPY: WHITE OWNER COPY (FINAL): YELLOW OWNER COPY (INITIAL): PINK