IREDELL COUNTY HEALTH DEPARTMENT

STATESVILLE 704-878-5305 COPY MOORESVILLE 704-664-5281

IMPROVEMENT PERMIT / AUTHORIZATION TO CONSTRUCT / OPERATION PERMIT / EXISTING SYSTEM INSPECTION

PERMIT# 146181 PIN# 4636835422 DATE 11-5-07

OWNER OR APPLICANT Wesley Zdcentan PHONE: Business 658-5106 Home

ADDRESS 120 Fantasy Ln Mooresville, NC 28117

LOCATION Brawley School Rd TL Canvasback on right before Spring Run

SUBDIVISION Mallard Head BLOCK / SECTION LOT 106 LOT AREA .46 Acre SITE CLASS PS DESIGN FLOW 480gpd L.T.A.R. .3

Septic Tank: 1000 Gallons; STB 825 Date 12-13-07
Pump Tank: Gallons; PT Date
Pump Make: Model Serial No.
Nitrification Field: No Fields 1 Square Feet 1200 Linear Feet 400
No Lines 4 Trench Width 36" Max Trench Bottom Depth 36" Gravel Depth N/A

☒ New System ☐ Repair ☐ Expansion System Type: I (II) III IV V VI
System Description: Gravity - 25% Reduction
Repair System Description: ☒ See Note - 50% Reduction
Maintenance Agreement Required: ☐ Yes ☒ No

☒ House/Mod. Home ☐ Mobile Home ☐ Business ☐ Other
No. Bedrooms 4 No. Persons No. Employees

Water Supply: ☒ Individual ☐ Public ☐ Community


☒ Gravity ☐ Pressure ☐ Slab ☒ Crawl Space ☐ Basement w/plumbing ☐ Basement wo/plumbing

Comments/Conditions: Okay to use "drop boxes" or distribution box.

Comments/Conditions: Note: Lot deeded prior to 1983

1:50

INITIAL SITE SKETCH

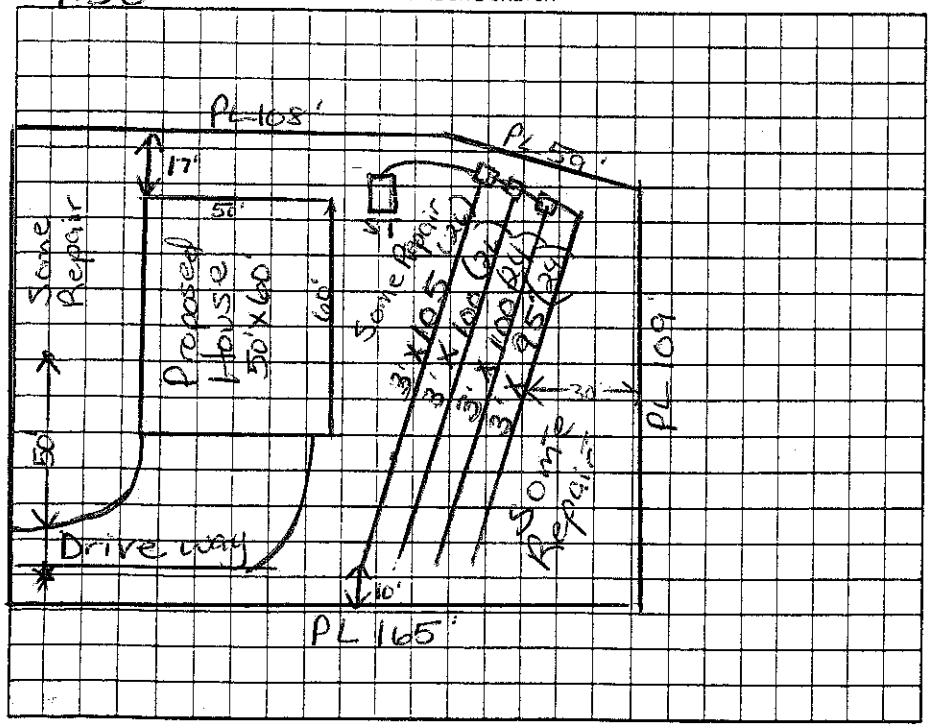

AS BUILT SKETCH

Installed Quick 4 w/ built in drop boxes as Drawn

Permit can be suspended or revoked if any false information is supplied toward securing the permit/any unauthorized changes are made to the site/any unauthorized changes are made in the installation of the system. Improvement Permit with plat valid without expiration ☐ Improvement Permit with site plan valid for sixty months ☐ Authorization to Construct is valid for a period equal to that of Improvement Permit – not to exceed sixty months.

Signed: date 11/6/07 Installed by: Rowan Septic RS

Improvement Permit by: Maria H Dolan RS date 11/5/07 Operation Permit by: Maria H Dolan date 1/23/08

Authorization to Construct by: Maria H Dolan RS date 11/5/07 Existing System Inspection by: date

HEALTH DEPT. COPY: WHITE OWNER COPY (FINAL): YELLOW OWNER COPY (INITIAL): PINK