IREDELL COUNTY HEALTH DEPARTMENT

STATESVILLE 704-878-5305 MOORESVILLE 704-664-5281

IMPROVEMENT PERMIT / CERTIFICATE OF COMPLETION / OPERATION PERMIT / EXISTING SYSTEM INSPECTION

PROPERTY DESCRIPTION NO. 20573 DATE 9/19/95 TAX MAP NO. 2K 9 A 103 Watershed: [X] Yes [ ] No

OWNER OR CONTRACTOR Charles Hammes PHONE: Business 4836-83-5727 Home 867-1728

ADDRESS 1942 E Rolling wood Rd. Gastonia NC 28054

LOCATION Cowan Lake Rd. on (R) before Spring Run

SUBDIVISION Holbrook Acres BLOCK / SECTION 1 LOT 103 LOT AREA 176 x 125 SITE CLASS. PS DESIGN FLOW 360 L.T.A.R. .35 (36")

Septic Tank: 1000 Gallons; STB 794 Date 12/13/95
Pump Tank: _____ Gallons; PT _____ Date _____
Pump Make: _____ Model _____ Serial No. _____
Nitrification Field: No Fields 1 Square Feet 1200 Linear Feet ~~400~~
No Lines 4 Trench Width 36" Max Trench Bottom Depth 32" Gravel Depth N/A

[X] New System [ ] Repair System Type: I, II, III, IV, V, VI
System Description: CRAW INFILTRATOR
Repair System Description: PRES PANEL
Maintenance Agreement Required: [ ] Yes [ ] No

[X] House/Mod. Home No. Bedrooms 3
[ ] Mobile Home No. Bathrooms 2.5
[ ] Business No. Employees _____
[ ] Other _____


[ ] Slab [X] Crawl Space [ ] Basement w/plumbing [ ] Basement wo/plumbing

Water Supply:
[ ] Individual
[X] Community
[ ] Public

Comments:
Tight - House location critical
Diversion ditching at rear very important
Use contours as much as possible

Comments:

INITIAL SITE SKETCH

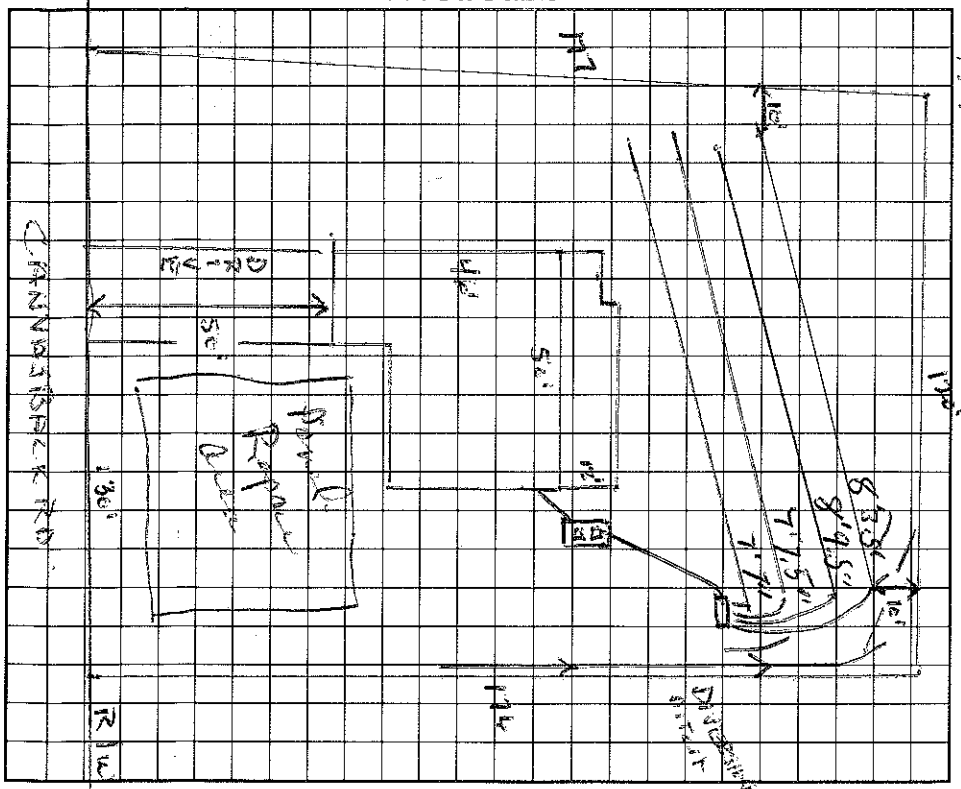

AS BUILT SKETCH

I understand that this permit can be suspended or revoked if any false information is supplied toward securing the permit/any unauthorized changes are made to the site/any unauthorized changes are made in the installation of the system.

Signed: x Kathy A Hammes

Improvement Permit by: Wesley Sparks R.S. date 9/19/95

Existing System Inspection by: _____ date _____

Installed by: Ray Beam

Certificate of Completion by: _____ date _____

Operation Permit by: C. Brad Treece EHSI date 3/13/96

HEALTH DEPT. COPY: WHITE INSPECTION COPY (FINAL): GREEN OWNER COPY (FINAL): YELLOW INSPECTION COPY (INITIAL): PINK OWNER COPY (INITIAL): GOLD